


WELL PLUGGING RECORD

Give All Information Completely
Make Required Affidavit
Mail or Deliver Report to:
Conservation Division
State Corporation Commission
211 No. Broadway
Wichita, Kansas

NORTH

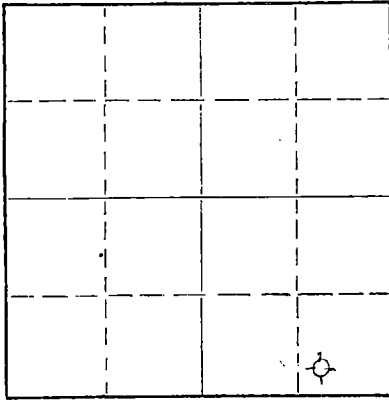

Locate well correctly on above
Section Plat

Stafford County, Sec. 15 Twp. 24 Rge. 14W (E) (W)
Location as "NE/CNW/SW" or footage from lines SW SE SE
Lease Owner C-G Drilling Co. Wichita 2, Kansas
Lease Name Neill Well No. 1
Office Address 107 Rule Bldg. Wichita 2, Kansas
Character of Well (completed as Oil, Gas or Dry Hole) D & A
Date well completed July 21, 1963
Application for plugging filed July 21, 1963
Application for plugging approved July 21, 1963
Plugging commenced July 21, 1963
Plugging completed July 21, 1963
Reason for abandonment of well or producing formation Too low structurally

If a producing well is abandoned, date of last production _____ 19____
Was permission obtained from the Conservation Division or its agents before plugging was commenced? Yes

Name of Conservation Agent who supervised plugging of this well Archie Elving Pratt, Kansas
Producing formation _____ Depth to top _____ Bottom _____ Total Depth of Well 4242 Feet
Show depth and thickness of all water, oil and gas formations.

OIL, GAS OR WATER RECORDS

CASING RECORD

FORMATION	CONTENT	FROM	TO	SIZE	PUT IN	PULLED OUT
				8-5/8"	207'	none

Describe in detail the manner in which the well was plugged, indicating where the mud fluid was placed and the method or methods used in introducing it into the hole. If cement or other plugs were used, state the character of same and depth placed, from _____ feet to _____ feet for each plug set.

Filled hole with heavy mud to 220'
Set plug. Put in 23 sks. cement and 1/2
sks. hulls. Filled to top with 1/2 sks.
hulls and 10 sks. cement.

RECEIVED
STATE CORPORATION COMMISSION

JUL 30 1963

CONSERVATION DIVISION
Wichita, Kansas

(If additional description is necessary, use BACK of this sheet)

Name of Plugging Contractor C-G Drilling Co.
Address 107 Rule Bldg., Wichita 2, Kansas

STATE OF KANSAS, COUNTY OF SEDGWICK, ss.
G. F. Galloway (~~employee of owner~~) or (owner or operator) of the above-described well, being first duly sworn on oath, says: That I have knowledge of the facts, statements, and matters herein contained and the log of the above-described well as filed and that the same are true and correct. So help me God.

(Signature) G. F. Galloway
107 Rule Bldg.
(Address)

SUBSCRIBED AND SWORN TO before me this 25 day of July, 1963

My commission expires May 20, 1967

Vicky Jacobs
Vicky Jacobs Notary Public.



W E L L L O G

OPERATOR C-G Drilling Co. SEC. 15-24-14W
 WELL NAME Neill #1 LOC. SW SE SE
 TOTAL DEPTH 4242' COUNTY Stafford
 COMM. 7/11/63 COMP. 7/21/63 STATE Kansas
 RIG NO. #2 ELEVATION 1951 K.B.
 CASING: Set 207' (6 jts.) 8-5/8" OD PRODUCTION: D & A
 Surface Casing

All measurements taken from the top of rotary bushing.

FROM	TO	FORMATION	DEVIATION FROM VERTICAL	REMARKS:
0	125	Sand		
125	390	Shale		
390	852	Red Bed		
852	880	Anhydrite		
880	1000	Red Bed-Shale	1000' - 0°	
1000	1290	Shale		
1290	1820	Shale-Shells	1500' - 0°	
1820	1935	Lime-Shale		
1935	2650	Lime-Shale	2000' - 0°	
2650	3370	Shale-Lime	2500' - 0°	
3370	3550	Lime-Shale	3000' - 0°	
3550	3642	Shale-Lime	3500' - 0°	
3642	4155	Lime		DST #1
4155	4190	Churt		3752-73
4190	4242	Lime-Shale		DST #2 4000-4030

RECEIVED
STATE CORPORATION COMMISSION

JUL 30 1963

CONSERVATION DIVISION
Wichita, Kansas

STATE OF KANSAS)
) SS.
 COUNTY OF SEDGWICK)

The undersigned hereby certifies that to the best of his knowledge and belief, the above facts are true and correct.

C-G DRILLING CO.

By G. F. Galloway

G. F. Galloway

SUBSCRIBED AND SWORN TO, BEFORE ME, THIS 25 day of July, 1963

My commission expires:
May 20, 1967

Wicky Jacobs
Wicky Jacobs - Notary Public