


Give All Information Completely
Make Required Affidavit
Mail or Deliver Report to:
Conservation Division
State Corporation Commission
212 No. Market
Wichita, Kansas

WELL PLUGGING RECORD

Stafford County, Sec. 5 Twp. 25S Rge. (E) 15 (W)
Location as "NE/CNWxSWx" or footage from lines 660' FWL & 1980' FSL SW/4
Lease Owner Kewanee Oil Company
Lease Name Barstow Well No. 1
Office Address P. O. Box 360, Hoisington, Kansas 67544
Character of Well (completed as Oil, Gas or Dry Hole) Dry Hole
Date well completed July 13, 1966
Application for plugging filed July 15, 1966
Application for plugging approved July 18, 1966
Plugging commenced July 15, 1966
Plugging completed July 15, 1966
Reason for abandonment of well or producing formation Dry Hole

NORTH

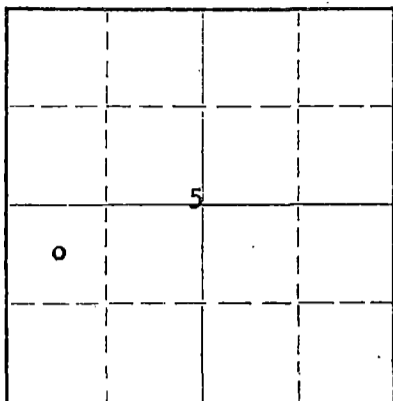

Locate well correctly on above
Section Plat

If a producing well is abandoned, date of last production _____ 19____
Was permission obtained from the Conservation Division or its agents before plugging was commenced? Yes - Verbal

Name of Conservation Agent who supervised plugging of this well Mr. Archie Elving, Pratt, Kansas
Producing formation _____ Depth to top _____ Bottom _____ Total Depth of Well 4340 Feet
Show depth and thickness of all water, oil and gas formations.

OIL, GAS OR WATER RECORDS

CASING RECORD

FORMATION	CONTENT	FROM	TO	SIZE	PUT IN	PULLED OUT
				8-5/8"	275	none

Describe in detail the manner in which the well was plugged, indicating where the mud fluid was placed and the method or methods used in introducing it into the hole. If cement or other plugs were used, state the character of same and depth placed, from _____ feet to _____ feet for each plug set.

Filled hole with mud to 240'. Set plug at 240'.
Dumped 1/4 sack hulls and 25 sacks cement.
Filled hole with mud to 40'. Set plug at 40'.
Dumped 1/4 sack hulls. Set 2 plugs and 10 sacks cement.
Cemented to bottom of cellar.

RECEIVED
STATE CORPORATION COMMISSION
JUL 20 1966
CONSERVATION DIVISION
Wichita, Kansas

(If additional description is necessary, use BACK of this sheet)

Name of Plugging Contractor Gabbert-Jones Drilling Company
Address Wichita, Kansas

STATE OF Kansas, COUNTY OF Sedgwick, ss.
Bill Patton (employee of owner) or (~~owner~~ or operator) of the above-described well, being first duly sworn on oath, says: That I have knowledge of the facts, statements, and matters herein contained and the log of the above-described well as filed and that the same are true and correct. So help me God.

(Signature) Bill Patton
P. O. Box 360, Hoisington, Kansas 67544
(Address)

SUBSCRIBED AND SWORN TO before me this 28th day of July, 19 66

My commission expires 8-2-69

Ann B Mc Nett
Notary Public.

GABBERT-JONES, INC.
 WICHITA, KANSAS
 DRILLERS' WELL LOG

BARSTOW #1
 C NW SW SECTION 5-25S-15W
 STAFFORD COUNTY, KANSAS

COMMENCED: JULY 3, 1966
 COMPLETED: JULY 15, 1966

OPERATOR - KEWANEE OIL COMPANY

DEPTH		FORMATION	REMARKS
FROM	TO		
0	215	SAND	
215	280	SHELLS AND BLUE SHALE	RAN 13 JOINTS OF 8-5/8" SURFACE CASING SET @ 275.39 W/225 SACKS CEMENT, PLUG TO 253'.
280	991	RED BED	
991	1005	ANHYDRITE	
1005	1150	RED BED AND SHALE	
1150	1820	SHALE	
1820	1995	SHALE AND LIME STREAKS	
1995	2285	SHALE AND LIME	
2285	2445	SHALE AND LIME STREAKS	
2445	2925	SHALE AND LIME	
2925	2985	LIME	
2985	3460	LIME AND SHALE	
3460	3478	LIME AND CHERT	
3478	3535	LIME AND SHALE	
3535	3654	LIME	
3654	3785	HEEBNER AND SHALE	
3785	4010	LIME	
4010	4060	CHERTY LIME	
4060	4245	LIME	
4245	4300	LIME AND SAND	
4300	4340	SAND AND SHALE	
4340	TD		DRY AND ABANDONED.

RECEIVED
 STATE COMPLETION COMMISSION
 JUL 29 1966
 COMPLETION DIVISION
 Wichita, Kansas

I, JAMES S. SUTTON, CERTIFY THIS IS A CORRECT COPY OF THE DRILLERS' LOG FOR THE WELL DRILLED IN THE C NW SW SECTION 5-25S-15W, STAFFORD COUNTY, KANSAS, TO THE BEST OF MY KNOWLEDGE AND BELIEF.

James S. Sutton
 JAMES S. SUTTON

STATE OF KANSAS)
) SS
 COUNTY OF SEDGWICK)

BEFORE ME, THE UNDERSIGNED, A NOTARY PUBLIC WITHIN AND FOR SAID COUNTY AND STATE, ON THIS 18TH DAY OF JULY, 1966, PERSONALLY APPEARED JAMES S. SUTTON, TO ME PERSONALLY KNOWN TO BE THE IDENTICAL PERSON WHO EXECUTED THE WITHIN AND FOREGOING INSTRUMENT AND ACKNOWLEDGED TO ME THAT HE EXECUTED THE SAME AS HIS FREE AND VOLUNTARY ACT AND DEED FOR THE USES AND PURPOSES THEREIN SET FORTH.

IN WITNESS WHEREOF, I HAVE HEREUNTO SET MY HAND AND OFFICIAL SEAL THE DAY AND YEAR LAST ABOVE WRITTEN.

Barbara J. Layton
 BARBARA J. LAYTON, NOTARY PUBLIC

My Commission Expires February 1, 1968.