

15-185-21281-0000

STATE OF KANSAS  
STATE CORPORATION COMMISSION

WELL PLUGGING RECORD

Give All Information Completely  
Make Required Affidavit  
Mail or Deliver Report to  
Conservation Division  
State Corporation Comm.  
245 North Water  
Wichita, KS 67202

Stafford County, Sec. 5 Twp. 25S Rge. 15W E/W  
Location as "NE/CNW $\frac{1}{4}$ SW $\frac{1}{4}$ " or footage from lines  
660' FNL; 1520' FWL, SW/4

Lease Owner F. G. Holl  
Lease Name Barstow #1-5 Well No. 1-5


Office Address 6427 East Kellogg, Wichita, Kansas 67207  
Character of Well (Completed as Oil, Gas or Dry Hole) Dry Hole

Date Well completed April 21, 1981  
Application for plugging filed April 21, 1981  
Application for plugging approved April 21, 1981  
Plugging commenced 9:00 AM, April 21, 1981  
Plugging completed 11:00 AM, April 21, 1981  
Reason for abandonment of well or producing formation Dry Hole

If a producing well is abandoned, date of last production 19

Was permission obtained from the Conservation Division or its agents before plugging was commenced? Yes

Name of Conservation Agent who supervised plugging of this well Maurice Leslie  
Producing formation \_\_\_\_\_ Depth to top \_\_\_\_\_ Bottom \_\_\_\_\_ Total Depth of Well 4375'  
Show depth and thickness of all water, oil and gas formations.

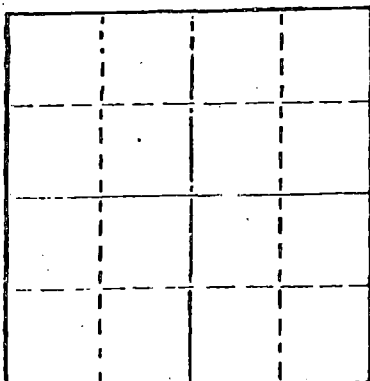

Locate well correctly on above Section Plat

OIL, GAS OR WATER RECORDS

CASING RECORD

FORMATION	CONTENT	FROM	TO	SIZE	PUT IN	PULLED OUT
				8 5/8"	278'	None

Describe in detail the manner in which the well was plugged, indicating where the mud fluid was placed and the method or methods used in introducing it into the hold. If cement or other plugs were used, state the character of same and depth placed, from \_\_\_\_\_ feet to \_\_\_\_\_ feet for each plug set.

Filled hole with heavy mud.  
Heavy mud pumped through open ended Drill Pipe;  
50 sacks at 520'; 40 sacks at 260'; Bridge, 1/2 sack hulls and plug with 10 sacks at 40'. 10 sacks in rat hole. Plug down at 11:00 AM, 4-21-81, by Howco.

5-6-81

STATE CORPORATION COMMISSION

MAV - 64001

(If additional description is necessary, use BACK of this sheet)

Name of Plugging Contractor Sterling Drilling Company, P. O. Box 129, Sterling, Kansas 67579  
Wichita, Kansas

STATE OF KANSAS COUNTY OF RICE, ss.  
F. A. Wuellner (employee of owner) or (owner or operator)

of the above-described well, being first duly sworn on oath, says: That I have knowledge of the facts, statements, and matters herein contained and the log of the above-described well as filed and that the same are true and correct. So help me God.

(Signature) F. A. Wuellner  
F. A. Wuellner, Secretary  
P. O. Box 129, Sterling, Kansas 67579  
(Address)

SUBSCRIBED AND SWORN TO before me this 22nd day of April, 1981



Agnes D. Wurst  
Agnes D. Wurst, Notary Public.

My commission expires \_\_\_\_\_

15-185-21281-0000

STERLING DRILLING COMPANY  
P. O. Box 129  
Sterling, Kansas 67579

WELL LOG ----- BARSTOW #1-5

Located: 660' FNL; 1520' FWL, SW/4, Section 5-25S-15W,  
Stafford County, Kansas

OWNER: F. G. Holl

ROTARY DRILLING CONTRACTOR: Sterling Drilling Company

COMMENCED: April 16, 1981

COMPLETED: April 21, 1981

TOTAL DEPTH: 4375'

<u>LOG</u>	<u>CASING RECORD</u>
0 - 111 Sand	Ran 7 joints 8 5/8", 24# new OD casing.
111 - 281 Shale and Sand Strs.	265.71' pipe set at 278' K.B. Cemented
281 - 655 Shale	with 225 sacks 60/40 Pozmix with 3% cc.
655 - 1002 Shale and Red Beds	Plug down at 12:30 PM, 4-16-81, by Howco.
1002 - 1019 Anhydrite	
1019 - 1655 Shale and Shells	
1655 - 2155 Shale	
2155 - 4333 Lime and Shale	
4333 - 4375 Shale, Chat, Lime	Plugged.

Deviation Surveys: 1/4° at 2155'  
1/2° at 4375'