


STATE OF KANSAS
STATE CORPORATION COMMISSION

WELL PLUGGING RECORD

Give All Information Completely
Make Required Affidavit
Mail or Deliver Report to
Conservation Division
State Corporation Comm.
245 North Water
Wichita, KS 67202

Sedgwick County, Sec. 32 Twp. 29S Rge. 2 NE/W
Location as "NE/CNW $\frac{1}{2}$ SW $\frac{1}{2}$ " or footage from lines
NE SW SW

Lease Owner Wiley Ash, Sr.
Lease Name R.E. Buchner Well No. 1
Office Address Rt 1, P.O. Box 114, Rose Hill, Ks. 67133
Character of Well (Completed as Oil, Gas or Dry Hole) _____

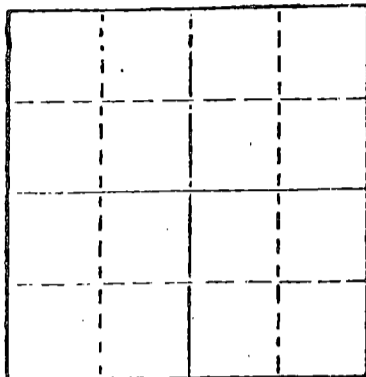

Locate well correctly on above
Section Plat

Date Well completed 5-2 19 80
Application for plugging filed 5-2 19 80
Application for plugging approved 5-2 19 80
Plugging commenced 5-2 19 80
Plugging completed 5-2 19 80

Reason for abandonment of well or producing formation
no commercial quantity of oil or gas encountered
If a producing well is abandoned, date of last production
-- 19

Was permission obtained from the Conservation Division or
its agents before plugging was commenced? yes

Name of Conservation Agent who supervised plugging of this well Don Thompson
Producing formation _____ Depth to top _____ Bottom _____ Total Depth of Well 4088
Show depth and thickness of all water, oil and gas formations.

OIL, GAS OR WATER RECORDS

CASING RECORD

FORMATION	CONTENT	FROM	TO	SIZE	PUT IN	PULLED OUT
surface hole	shale	surf	239'	8-5/8"	237	none

Describe in detail the manner in which the well was plugged, indicating where the mud fluid was placed and the method or methods used in introducing it into the hold. If cement or other plugs were used, state the character of same and depth placed, from _____ feet to _____ feet for each plug set.

Fluid to 250', plug, 1/4 sx hulls, 25 sx 5-8-80
Fluid to 40', plug, 1/4 sx hulls, 12 sx
Rat hole 3 sx

RECEIVED
STATE CORPORATION COMMISSION
MAY 8 1980
CONSERVATION DIVISION

(If additional description is necessary, use BACK of this sheet)

Name of Plugging Contractor D N B DRILLING, INC.
515 R. H. Garvey Building
Wichita, Kansas 67202

STATE OF Kansas COUNTY OF Sedgwick, ss.
Ella Priess (employee of owner) or (owner or operator)

of the above-described well, being first duly sworn on oath, says: That I have knowledge of the facts, statements, and matters herein contained and the log of the above-described well as filed and that the same are true and correct. So help me God.

(Signature) Ella Priess
515 R.H. Garvey Bldg., Wichita, Ks. 67202
(Address)

SUBSCRIBED AND SWORN TO before me this 5th day of May, 19 80

My commission expires April 30, 1983

Dorothy L. Schmidt
Dorothy L. Schmidt Notary Public.

DOROTHY L. SCHMIDT
STATE NOTARY PUBLIC
Sedgwick County, Kansas
My Appt. Exp. April 30, 1983

DRILLER'S LOG

WILEY ASH, SR.
 No. 1 R.E. Buchner
 NE SW SW
 Sec. 32-29S-2W
 Sedgwick Co., Ks.

Commenced: 4-21-80
 Completed: 5-2-80

Surface Casing: 237' of 8-5/8"
 cemented w/225 sx common, 3% cc
 4-21-80

<u>FORMATION</u>	<u>DEPTH</u>
Surface Hole	0 - 239
Sand & Shale	239 - 490
Shale & Lime	490 - 915
Shale	915 - 1244
Shale & Lime	1244 - 1315
Shale	1315 - 1321
Shale & Lime	1321 - 1704
Sand, Shale & Lime Streaks	1704 - 2216
Shale & Lime	2216 - 2384
Lime & Shale	2384 - 2504
Shale & Lime	2504 - 3206
Shale & Sand	3206 - 3218
Shale	3218 - 3225
Lime & Shale	3225 - 3311
Lime	3311 - 3385
Shale & Lime	3385 - 3560
Lime & Shale	3560 - 4078
Shale & Sand	4078 - 4085
Lime & Shale	4085 - 4088 RTD

I do hereby certify that the foregoing statements are true and correct to the best of my knowledge and belief.

D N B DRILLING, INC.

Ella Priess 5-8-80
 Ella Priess

STATE OF KANSAS: ss:

Subscribed and sworn to before me this 5th day of May, 1980.

DOROTHY L. SCHMIDT
 STATE NOTARY PUBLIC
 Sedgwick County, Kansas
 My Aplt. Exp. April 30, 1983

Dorothy L. Schmidt
 Dorothy L. Schmidt, Notary Public