


STATE OF KANSAS  
STATE CORPORATION COMMISSION

WELL PLUGGING RECORD

Give All Information Completely  
Make Required Affidavit  
Mail or Deliver Report to:  
Conservation Division  
State Corporation Commission  
211 No. Broadway  
Wichita, Kansas

Sedgwick County. Sec. 15 Twp. 29 Rge. 2W (E) (W)  
Location as "NE/CNW/SW" or footage from lines SW NW NE  
Lease Owner Shawver-Armour, Inc.  
Lease Name Hobart Chambers Well No. 2  
Office Address 817 Central Building, Wichita, Kansas  
Character of Well (completed as Oil, Gas or Dry Hole) Dry hole  
Date well completed 4/23 19 58  
Application for plugging filed 4/23 19 58  
Application for plugging approved 4/23 19 58  
Plugging commenced 4/23 19 58  
Plugging completed 4/23 19 58  
Reason for abandonment of well or producing formation Dry hole

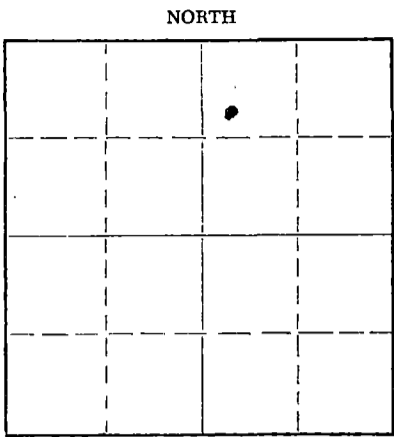

Locate well correctly on above  
Section Plat

If a producing well is abandoned, date of last production \_\_\_\_\_ 19 \_\_\_\_  
Was permission obtained from the Conservation Division or its agents before plugging was commenced? Yes

Name of Conservation Agent who supervised plugging of this well Eugene Graham  
Producing formation MISSISSIPPIAN Depth to top 3549 Bottom 3593 Total Depth of Well 3593 Feet  
Show depth and thickness of all water, oil and gas formations.

OIL, GAS OR WATER RECORDS

CASING RECORD

FORMATION	CONTENT	FROM	TO	SIZE	PUT IN	PULLED OUT
Surface	water	0	200'	8 5/8"	200'	None

Describe in detail the manner in which the well was plugged, indicating where the mud fluid was placed and the method or methods used in introducing it into the hole. If cement or other plugs were used, state the character of same and depth placed, from \_\_\_\_\_ feet to \_\_\_\_\_ feet for each plug set.

Fill with heavy mud 3593 to 195 then  
# 1 Plug 195' 15 sx cement 1/2 hulls  
# 2 Plug 35' from cellar 1/2 hulls 10 sx. cement

(If additional description is necessary, use BACK of this sheet)  
Name of Plugging Contractor Shawver Armour, Inc.  
Address 817 Central Building, Wichita, Kansas

STATE OF KANSAS, COUNTY OF SEDGWICK, ss.  
JAMES M. ARMOUR (employee of owner) or (owner or operator) of the above-described well, being first duly sworn on oath, says: That I have knowledge of the facts, statements, and matters herein contained and the log of the above-described well as filed and that the same are true and correct. So help me God.

(Signature) James M. Armour  
JAMES M. ARMOUR  
817 Central Bldg. Wichita, Ks.  
(Address)

SUBSCRIBED AND SWORN TO before me this 23 day of April, 19 58

My commission expires Dec. 29, 1959  
MARJORIE HAZEL Notary Public.

RECEIVED  
STATE CORPORATION COMMISSION

MAY 8 1958  
CONSERVATION DIVISION  
Wichita, Kansas

PLUGGING  
FILE SEC. 15 T 29 R 24  
BOOK PAGE 96 LINE 28

DRILLER'S LOG

FARM NAME: HOBART CHAMBERS # 2

COMPANY: SHAWVER ARMOUR, INC.

CONTRACTOR: SHAWVER ARMOUR, INC.

COMMENCED: April 13, 1958

LOCATION: SW NW NE Section 15-29-2W  
Sedgwick County, Kansas

ELEVATION: 1307 K.B.

COMPLETED: April 23, 1958

CASING RECORD

200' 8 5/8" W/160 sx. 2% CC

FORMATION

Clay & Sand Shale	60
Hard Blue Shale	175
Gray Shale	235
Salt slightly embedded in	
Gray & Blue Shale	400
Lime & Shale Streaks	700
Lime & Shale	1030
Shale & Lime	1055
Shale & Lime Streaks	1255
Shale & Lime	1965
Shale & Lime Streaks	2230
Lime & Shale	2555
Lime & Sandy Shale	2740
Stalnaker Sand	2770
Shale & Lime	3030
Kansas City Lime B/ ?	-3135
Lime & Shale	3430
Shale & Lime	3557
Mississippian Lime	3577
Ream Core Hole	3593 RTD D & A

TOPS

Top Kansas City	2941
Base Kansas City	2941 - ?
Oswego	3196
Mississippian	3549

STATE OF KANSAS )  
                          ) SS  
SEDGWICK COUNTY )

I, James M. Armour, do hereby certify that the above is a true and correct copy of the log on the above captioned well, as shown on the daily drilling reports.

SHAWVER ARMOUR, INC.

BY James M. Armour  
JAMES M. ARMOUR

Subscribed and sworn to before me  
this 23 day of April, 1958

My commission expires Dec. 29, 1959

Marjorie Hall  
MARJORIE HALL, NOTARY PUBLIC

RECEIVED

STATE CORPORATION COMMISSION

MAY 8 1958

CONSERVATION DIVISION  
Wichita, Kansas

PLUGGING  
FILE SEC 15 T 29 R 24  
BOOK PAGE 96 LINE 28