


WELL PLUGGING RECORD

Give All Information Completely
Make Required Affidavit
Mail or Deliver Report to:
Conservation Division
State Corporation Commission
800 Bitting Building
Wichita, Kansas

NORTH

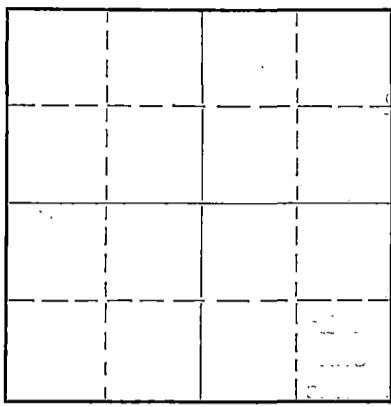

Locate well correctly on above
Section Plat

Stafford County. Sec. 28 Twp. 24 Rge. 13 XE (W)
Location as "NE/CNW $\frac{1}{4}$ SW $\frac{1}{4}$ " or footage from lines C-NE $\frac{1}{4}$ -NE $\frac{1}{4}$ -SE $\frac{1}{4}$
Lease Owner Midstates Oil Corporation
Lease Name Tanner Well No. 1
Office Address 518 National Bank of Tulsa Bldg., Tulsa 3, Oklahoma
Character of Well (completed as Oil, Gas or Dry Hole) Oil
Date well completed November 10, 19.50
Application for plugging filed January 15, 19.51
Application for plugging approved January 15, 19.51
Plugging commenced January 15, 19.51
Plugging completed January 26, 19.51
Reason for abandonment of well or producing formation Insufficient Production

If a producing well is abandoned, date of last production December 1, 19.50
Was permission obtained from the Conservation Division or its agents before plugging was commenced? Yes

Name of Conservation Agent who supervised plugging of this well C. D. Stough
Producing formation Lansing Lime Depth to top 3738' Bottom 3760' Total Depth of Well 4160 Feet
Show depth and thickness of all water, oil and gas formations.

OIL, GAS OR WATER RECORDS

CASING RECORD

Formation	Content	From	To	Size	Put In	Pulled Out
				8-5/8"	329'	None
				5-1/2"	3880'	1867'

Describe in detail the manner in which the well was plugged, indicating where the mud fluid was placed and the method or methods used in introducing it into the hole. If cement or other plugs were used, state the character of same and depth placed, from _____ feet to _____ feet for each plug set.

Plugged back from 3734' to 3715' with crushed rock. From 3715' to 3685' with cement. From 3685' to 300' with heavy mud. From 300' to bottom of cellar with cement squeezed in by Halliburton.


Conservation Division
2-9-51

(If additional description is necessary, use BACK of this sheet)

Correspondence regarding this well should be addressed to George M. Vandaveer, Jr., Midstates Oil Corporation,
Address 518 National Bank of Tulsa Building, Tulsa 3, Oklahoma

STATE OF Oklahoma, COUNTY OF Tulsa, ss.
George M. Vandaveer, Jr. (employee of owner) or (owner or operator) of the above-described well,
being first duly sworn on oath, says: That I have knowledge of the facts, statements, and matters herein contained and the log of the above-described well as filed and that the same are true and correct. So help me God.
Vice President (Signature) Geo. M. Vandaveer, Jr.
518 Nat'l. Bank of Tulsa Bldg., Tulsa 3, Okla. (Address)

SUBSCRIBED AND SWORN TO before me this 7th day of February, 19.51
BRATCHER E. PARK, Notary Public in and for Tulsa County, Okla.
My commission expires _____
Notary Public.

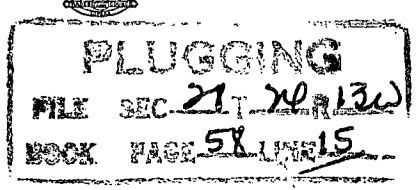

FORMATION RECORD

<u>From</u>	<u>To</u>	<u>Formation</u>
0	290	Sand
290	335	Red Bed & shale
335	735	Red Bed
735	770	Red Bed
770	800	Anhydrite
800	1290	Shale, shells
1290	1740	Shale, shells
1740	1770	Shale, shells
1770	1875	Shale, lime
1875	1975	Lime
1975	2040	Shale, lime
2040	2120	Broken Lime
2120	2220	Lime
2220	2285	Lime & Shale
2285	2633	Lime & Shale
2633	2805	Shale
2805	2950	Shale
2950	3200	Shale & Lime
3200	3450	Lime
3450	3525	Shale & lime
3525	3553	Shale
3553	3955	Lime
3955	3990	Viola Lime
3990	4027	Cherty Viola Lime
4027	4073	Cherty Lime
4073	4082	Shale
4082	4130	Shale & Lime
4130	4160	Arbuckle Lime
Total Depth	4160	

CORPORATION COMMISSION OF

KANSAS

WELL RECORD

PRODUCER: Midstates Oil Corporation
 ADDRESS: 518 National Bank of Tulsa Building, Tulsa 3, Oklahoma
 FARM NAME: Tanner WELL NO.: One
 WELL LOCATED: NE NE SE SECTION 28-24-13, Stafford County, Kansas
 COMMENCED DRILLING: 10-26-49 DRILLING COMPLETED: 11-10-49

CASING RECORD

8-5/8" surface casing set at 329' cemented w/200 sacks of cement and 2 sacks Calcium Chloride by Halliburton.
 5-1/2" production casing set at 3885', cemented w/200 sacks.

FORMATION RECORD

<u>From</u>	<u>To</u>	<u>Formation</u>
0	290	Sand
290	335	Red Bed & shale
335	735	Red Bed
735	770	Red Bed
770	800	Anhydrite
880	1290	Shale, shells
1290	1740	Shale, shells
1740	1770	Shale, shells
1770	1875	Shale, lime
1875	1975	Lime
1975	2040	Shale, lime
2040	2120	Broken Lime
2120	2220	Lime
2220	2285	Lime & shale
2285	2633	Lime & shale
2633	2805	Shale
2805	2950	Shale
2950	3200	Shale, lime
3200	3450	Lime
3450	3525	Shale, lime
3525	3553	Shale
3553	3955	Lime
3955	3990	Viola Lime
3990	4027	Cherty Viola Lime
4027	4073	Cherty Lime
4073	4082	Shale
4082	4130	Shale, lime
4130	4160	Arbuckle Lime
Total Depth	4160	

Date: February 8, 1951

RECEIVED
 STATE CORPORATION COMMISSION
 FEB 9 1951
 CONSERVATION DIVISION
 Wichita, Kansas

2-9-51

