


STATE OF KANSAS
STATE CORPORATION COMMISSION

WELL PLUGGING RECORD

Give All Information Completely
Make Required Affidavit
Mail or Deliver Report to
Conservation Division
State Corporation Comm.
245 North Water
Wichita, KS 67202

Stafford County, Sec. 13 Twp. 24S Rge. 15W E/W
Location as "NE/CNW $\frac{1}{4}$ SW $\frac{1}{4}$ " or footage from lines
App. C S/2 S/2 NE/4 (330' fsl & 1200' fel of NE/4)
Lease Owner Murfin Drilling Company
Lease Name English Reid C Well No. 1
Office Address 617 Union Center, Wichita, Kansas 67202
Character of Well (Completed as Oil, Gas or Dry Hole) Dry hole

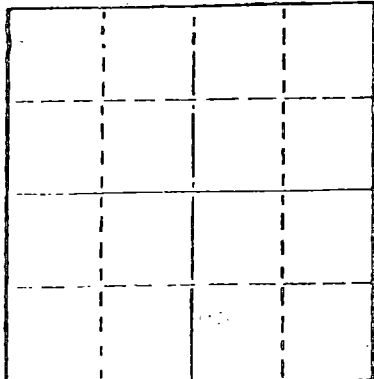

Locate well correctly on above
Section Plot

Date Well completed April 17, 1977
Application for plugging filed April 17, 1977
Application for plugging approved April 17, 1977
Plugging commenced April 17, 1977
Plugging completed April 17, 1977
Reason for abandonment of well or producing formation Dry hole
If a producing well is abandoned, date of last production 19

Was permission obtained from the Conservation Division or
its agents before plugging was commenced? yes

Name of Conservation Agent who supervised plugging of this well J. W. Metz
Producing formation _____ Depth to top _____ Bottom _____ Total Depth of Well 4420'
Show depth and thickness of all water, oil and gas formations.

OIL, GAS OR WATER RECORDS

CASING RECORD

FORMATION	CONTENT	FROM	TO	SIZE	PUT IN	PULLED OUT
				8-5/8"	530'	-

Describe in detail the manner in which the well was plugged, indicating where the mud fluid
was placed and the method or methods used in introducing it into the hold. If cement or other
plugs were used, state the character of same and depth placed, from _____ feet to
_____ feet for each plug set.

Mud to 550', 35 sacks cement
Mud to 40', 1/2 sack hulls, 15 sacks cement
5 sacks in rathole

STATE CORPORATION COMMISSION

APR 20 1977
4-20-77
CONSERVATION DIVISION
Wichita, Kansas

(If additional description is necessary, use BACK of this sheet)

Name of Plugging Contractor _____

STATE OF KANSAS COUNTY OF SEDGWICK, ss.
Don Gardner (employee of owner) or (owner) or (operator)
of the above-described well, being first duly sworn on oath, says: That I have knowledge of
the facts, statements, and matters herein contained and the log of the above-described well
as filed and that the same are true and correct. So help me God.

(Signature) Don Gardner
Suite 250, 200 W. Douglas, Wichita, KS 67202
(Address)

SUBSCRIBED AND SWORN TO before me this 19th day of April, 1977

Kathleen L. Durbin
Notary Public.

My commission expires January 4, 1981

DRILLERS LOG

ENGLISH-REID C-1
 App. C S/2 S/2 NE/4 Section 13-24S-15W
 Stafford County, Kansas

OPERATOR: MURFIN DRILLING COMPANY
 617 Union Center
 Wichita, Kansas 67202

CONTRACTOR: DUNNE-GARDNER PETROLEUM, INC.
 Suite 250, 200 West Douglas
 Wichita, Kansas 67202

COMMENCED: April 8, 1977

COMPLETED: April 17, 1977

CASING RECORD: 8-5/8" @ 530' w/325 sx

<u>FROM</u>	<u>TO</u>	<u>DESCRIPTION</u>
0	100	Sand
100	430	Shale and red bed
430	480	Sand
480	530	Shale
530	953	Sand and shale
953	971	Anhydrite
971	1415	Shale and shells
1415	1800	Shale and shells
1800	1950	Shale and lime
1950	2125	Broken lime
2125	2580	Lime and shale
2580	2790	Broken lime
2790	3155	Lime and shale
3155	3325	Lime
3325	3715	Lime and shale
3715	3850	Lime
3850	3960	Lime and shale
3960	4040	Lime
4040	4080	Cherty lime
4080	4145	Lime
4145	4220	Sand
4220	4420	Lime
4420		Rotary total depth

RECEIVED
 STATE CORPORATION COMMISSION
 APR 20 1977
 CONSERVATION DIVISION
 Wichita, Kansas


STATE OF KANSAS)
) ss
 COUNTY OF SEDGWICK)

I hereby certify that the above is a true and correct log to the best of my knowledge and belief.


 Don Gardner

Subscribed and sworn to before me this 19th day of April, 1977.

My appointment expires:
 January 4, 1981

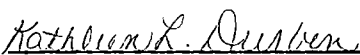
 Notary Public