


STATE OF KANSAS
STATE CORPORATION COMMISSION

WELL PLUGGING RECORD

Give All Information Completely
Make Required Affidavit
Mail or Deliver Report to
Conservation Division
State Corporation Comm.
245 North Water
Wichita, KS 67202

Stafford County. Sec. 12 Twp. 24S Rge. 15 E/W
Location as "NE/CNW $\frac{1}{4}$ SW $\frac{1}{4}$ " or footage from lines C SE/4

Lease Owner The Roxana Corporation
Lease Name Doran Well No. 1
Office Address Box 1162, Great Bend, Ks. 67530
Character of Well (Completed as Oil, Gas or Dry Hole) Dry hole

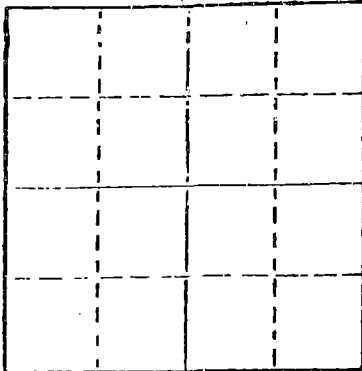

Locate well correctly on above
Section Plot

Date Well completed Mar. 23 1981
Application for plugging filed Mar. 23 1981
Application for plugging approved Mar. 23 1981
Plugging commenced Mar. 23 1981
Plugging completed Mar. 23 1981
Reason for abandonment of well or producing formation Dry Hole

If a producing well is abandoned, date of last production 19

Was permission obtained from the Conservation Division or its agents before plugging was commenced? Yes

Name of Conservation Agent who supervised plugging of this well Morris Lesslie
Producing formation _____ Depth to top _____ Bottom _____ Total Depth of Well 4300'
Show depth and thickness of all water, oil and gas formations.

OIL, GAS OR WATER RECORDS

CASING RECORD

FORMATION	CONTENT	FROM	TO	SIZE	PUT IN	PULLED OUT
				8 5/8"	290'	

Describe in detail the manner in which the well was plugged, indicating where the mud fluid was placed and the method or methods used in introducing it into the hold. If cement or other plugs were used, state the character of same and depth placed, from _____ feet to _____ feet for each plug set.

- 1st plug @ 520' w/ 50 sks
- 2nd plug @ 295' w/ 40 sks
- 3rd plug @ 40' w/ 10 sks
- 10 sks in rat hole

RECEIVED
STATE CORPORATION COMMISSION
4-3-81
APR - 3 1981

(If additional description is necessary, use BACK of this sheet)

Name of Plugging Contractor RoCo Drilling, Inc.


CONSERVATION DIVISION
Wichita, Kansas

STATE OF Kansas COUNTY OF Barton, ss.
Richard L. Miller (employee of owner) or (owner or operator)
of the above-described well, being first duly sworn on oath, says: That I have knowledge of the facts, statements, and matters herein contained and the log of the above-described well as filed and that the same are true and correct. So help me God.

(Signature) Richard L. Miller
1925 Main, Great Bend, Ks.
(Address)

SUBSCRIBED AND SWORN TO before me this 1 day of April, 1981

Mary C. Shubs
Notary Public.

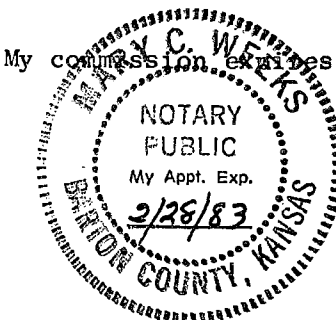

February 28, 1983

ROCO DRILLING, INC.

GREAT BEND, KANSAS 67530

P. O. BOX 11
1819 ELEVENTH STREET
TELEPHONE (316) 792-1383

DRILLERS WELL LOG

Doran #1
C SE/4, Section 12-24S-15W
Stafford County, Ks.

Operator: The Roxana Corporation
Box 1162
Great Bend, Ks. 67530

Date Commenced: March 18, 1981
Date Completed: March 23, 1981

Elevation: 2005' K.B.
Total Depth: 4300'
D&A

Casing: 8 5/8" @ 290' w/ 225 sks.

DEPTH		FORMATION	SAMPLE TOPS	
FROM	TO			
0	485	Surface Soil, Sand & Shells	Heebner	3567
485	952	Shale & Shells	Toronto	3586
952	970	ANHYDRITE	Brown Lime	3709
970	1984	Shale, Gyp & Shells	Lansing	3722
1984	3567	Lime, Shale & Sand	Conglomerate	4036
3567	3572	HEEBNER SHALE	Viola	4241
3572	3709	Lime, Shale & Silt		
3709	4018	Lime & Shale		
4018	4300	Shale, Chert & Sand		
	4300	Rotary Total Depth		

I, Richard L. Miller, certify this is a correct copy of the Driller's Log from the well drilled at the above location, to the best of my knowledge and belief.

Signed Richard L. Miller
Richard L. Miller

RECEIVED
STATE CORPORATION COMMISSION

APR - 3 1981

CONSERVATION DIVISION
Wichita, Kansas