


STATE OF KANSAS
STATE CORPORATION COMMISSION

WELL PLUGGING RECORD

Give All Information Completely
Make Required Affidavit
Mail or Deliver Report to:
Conservation Division
State Corporation Commission
212 North Market, Insurance Bldg.
Wichita, Kansas

Sedgwick County, Sec. 13 Twp. 29 Rge. 1 (E) W (W)

Location as "NE/CNW/SW" or footage from lines SW SW SW (NE SE SW?)
Lease Owner Colorado Gas & Mining and Harvest Queen Milling
Lease Name Roy #3 Well No. Co.
Office Address Denver, Colorado
Character of Well (completed as Oil, Gas or Dry Hole)
Date well completed 19
Application for plugging filed 19
Application for plugging approved 19
Plugging commenced 1-7-59 19
Plugging completed 1-12-59 19
Reason for abandonment of well or producing formation

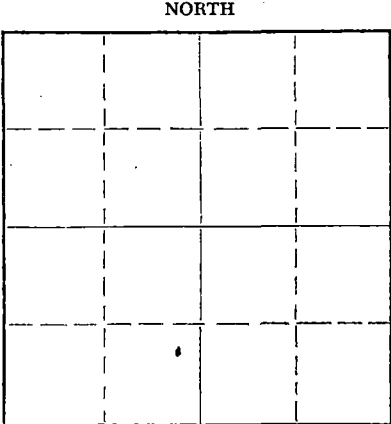

Locate well correctly on above Section Plat

If a producing well is abandoned, date of last production 19
Was permission obtained from the Conservation Division or its agents before plugging was commenced? yes

Name of Conservation Agent who supervised plugging of this well Gene Graham
Producing formation Depth to top Bottom Total Depth of Well 3365 Feet
Show depth and thickness of all water, oil and gas formations.

OIL, GAS OR WATER RECORDS

CASING RECORD

FORMATION	CONTENT	FROM	TO	SIZE	PUT IN	PULLED OUT
				8-5/8"	235'	none
				4-1/2"	3359'	2426'

Describe in detail the manner in which the well was plugged, indicating where the mud fluid was placed and the method or methods used in introducing it into the hole. If cement or other plugs were used, state the character of same and depth placed, from feet to feet for each plug set.

Checked the hole to 3365' and found it open.
Filled w/sand to 3350' and dumped 4 sacks of cement with bailer. Pulled 4 1/2" casing, cleared hole and mudded the hole to 230', set 10' rock bridge and dumped 15 sacks of cement. Mudded the hole to 20', set 5' rock bridge and ran 5 sacks of cement to base of cellar.

RECEIVED
STATE CORPORATION COMMISSION

FEB 13 1959

CON DIVISION
Wichita, Kansas

PLUGGING COMPLETED

(If additional description is necessary, use BACK of this sheet)
Name of Plugging Contractor West Supply Co., Inc.
Address Chase, Kansas

STATE OF KANSAS, COUNTY OF RICE, ss.
I, Noel J. Knight (employee of owner) or (owner or operator) of the above-described well, being first duly sworn on oath, says: That I have knowledge of the facts, statements, and matters herein contained and the log of the above-described well as filed and that the same are true and correct. So help me God.

(Signature) Noel J. Knight
Chase, Kansas (Address)

SUBSCRIBED AND SWORN to before me this 23rd day of January, 1959

9-27-62

Thomas V. Dyer
Notary Public.

My commission expires

PLUGGING
FILE SEC 13 T. 29 R. 1W
BOOK PAGE 7 LINE 2