


15-173-01504-0000

STATE OF KANSAS  
STATE CORPORATION COMMISSION

Give All Information Completely  
Make Required Affidavit  
Mail or Deliver Report to:  
Conservation Division  
State Corporation Commission  
800 Biting Building  
Wichita, Kansas

WELL PLUGGING RECORD

NORTH

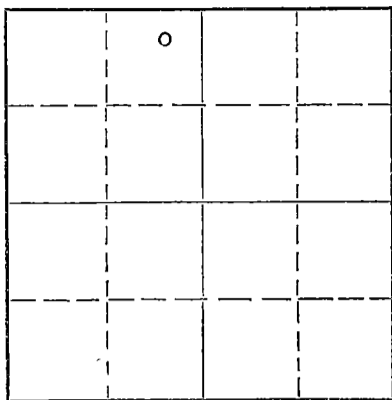

Locate well correctly on above  
Section Plat

Sedgwick County. Sec. 13 Twp. 29 Rge. (E) 1 (W)  
Location as "NE/CNW/SW" or footage from lines NE NE NW  
Lease Owner Renfro Drilling Co.  
Lease Name Roy Well No. 1  
Office Address 316 Insurance Bldg.  
Character of Well (completed as Oil, Gas or Dry Hole) Dry Hole  
Date well completed 10-11 19 56  
Application for plugging filed 10-11 19 56  
Application for plugging approved 10-11 19 56  
Plugging commenced 10-11 19 56  
Plugging completed 10-11 19 56  
Reason for abandonment of well or producing formation Dry Hole

If a producing well is abandoned, date of last production 19  
Was permission obtained from the Conservation Division or its agents before plugging was commenced? Yes

Name of Conservation Agent who supervised plugging of this well Ruel Durkee  
Producing formation \_\_\_\_\_ Depth to top \_\_\_\_\_ Bottom \_\_\_\_\_ Total Depth of Well 3353 Feet  
Show depth and thickness of all water, oil and gas formations.

OIL, GAS OR WATER RECORDS

CASING RECORD

FORMATION	CONTENT	FROM	TO	SIZE	PUT IN	PULLED OUT

Describe in detail the manner in which the well was plugged, indicating where the mud fluid was placed and the method or methods used in introducing it into the hole. If cement or other plugs were used, state the character of same and depth placed, from \_\_\_\_\_ feet to \_\_\_\_\_ feet for each plug set.

Set plug #1 at 150 feet. Mixed 25 sacks cement. Filled with mud. Set plug #2 at 8 feet. Filled with 8 sacks cement.

(If additional description is necessary, use BACK of this sheet)

Name of Plugging Contractor Renfro Drilling Co.  
Address 316 Insurance Bldg., Wichita, Kansas

STATE OF KANSAS, COUNTY OF SEDGWICK, ss.  
Henry D. Ficken (employee of owner) or (~~owner or operator~~) of the above-described well, being first duly sworn on oath, says: That I have knowledge of the facts, statements, and matters herein contained and the log of the above-described well as filed and that the same are true and correct. So help me God.

(Signature) Henry D. Ficken  
316 Insurance Bldg., Wichita, Kansas  
(Address)

SUBSCRIBED AND SWORN TO before me this 18th day of October, 19 56

My commission expires May 4, 1959

Joanne Leslie  
Joanne Leslie Notary Public.

24-7368-S 3-53-20M

PLUGGING  
FILE SEC. 13 T. 29 R. 1W  
BOOK PAGE 107 LINE 24

OCT 23 1956 10-23-56

CONSERVATION DIVISION  
WICHITA, KANSAS

DRILLERS' LOG

Commenced 10-1-56  
 Completed 10-11-56  
 Elevation 1292 RB

RENFRO DRILLING CO. #1 ROY  
 NE NE NW Section 13-29S-1W  
 Sedgwick County, Kansas

0 - 40	Surface soil
40 - 55	Sand
55 - 85	Shale and shells
85 - 100	Sand
100 - 160	Shale and shells
160 - 205	Shale and shells
205 - 405	Shale, sand and shells
405 - 588	Lime and shale
588 - 800	Lime and shale
800 - 1025	Lime and shale
1025 - 1115	Lime and shale
1115 - 1275	Shale and shells
1275 - 1505	Shale and shells
1505 - 1735	Shale
1735 - 1974	Lime and shale
1974 - 2135	Lime and shale
2135 - 2227	Lime and shale
2227 - 2250	Sand
2250 - 2270	Shale
2270 - 2415	Shale and sand
2415 - 2430	Shale and sand
2430 - 2445	Lime
2445 - 2550	Sand
2550 - 2570	Shale
2570 - 2715	Shale and lime
2715 - 2752	Sand and shale
2752 - 2803	Lime
2803 - 2884	Lime
2884 - 2942	Lime
2942 - 2954	Lime
2954 - 3037	Shale and lime
3037 - 3118	Lime and shale
3118 - 3187	Lime, broken
3187 - 3275	Lime and shale
3275 - 3311	Shale and lime
3311 - 3313	Lime
3313 - 3315	Shale and sand
3315 - 3322	Shale and lime
3322 - 3337	Lime and dolomite
3337 - 3352	Lime and dolomite
3353 -	Total Depth (Steel line measurement)

STATE OF KANSAS )  
 )ss  
 COUNTY OF SEDGWICK)

RECEIVED  
 STATE CORPORATION COMMISSION  
 OCT 19 1956

CONSERVATION DIVISION

I, the undersigned, being duly sworn on oath, state that the above Drillers' Log is true and correct to the best of my knowledge and belief and according to the records of this office.

PLUGGING  
 FILE SEC 13 T 29 R 1W  
 BOOK PAGE 107 LINE 24

RENFRO DRILLING CO.

By Henry S. Ficken

Subscribed and sworn to before me this 18th day of October, 1956.

My commission expires May 4, 1959.

James Leslie  
 Notary Public