


STATE OF KANSAS

STATE CORPORATION COMMISSION

Give All Information Completely
Make Required Affidavit
Mail or Deliver Report to:
Conservation Division
State Corporation Commission
800 Bittling Building
Wichita, Kansas

WELL PLUGGING RECORD

NORTH

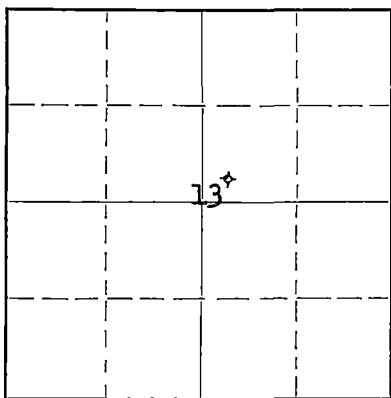

Locate well correctly on above
Section Plat

Sedgwick County. Sec. 13 Twp. 29 Rge. (E) 1 (W)
Location as "NE/CNW $\frac{1}{4}$ SW $\frac{1}{4}$ " or footage from lines SW SW NE
Lease Owner Kewanee Oil Company
Lease Name Roy Well No. 1
Office Address Box 428, Shidler, Oklahoma
Character of Well (completed as Oil, Gas or Dry Hole) Dry Hole
Date well completed 2-7-1954
Application for plugging filed 2-8-1954
Application for plugging approved 2-2-1954
Plugging commenced 2-7-1954
Plugging completed 2-7-1954
Reason for abandonment of well or producing formation Dry Hole

If a producing well is abandoned, date of last production 19

Was permission obtained from the Conservation Division or its agents before plugging was commenced? Yes

Name of Conservation Agent who supervised plugging of this well Ruel Durkee

Producing formation Depth to top Bottom Total Depth of Well 3355 Feet

Show depth and thickness of all water, oil and gas formations.

OIL, GAS OR WATER RECORDS

CASING RECORD

Formation	Content	From	To	Size	Put In	Pulled Out
Lansing	Dry	2411		8-5/8"	167.74'	None
Kansas City	Dry	2750		5 1/2"	3328.40'	2411.61'
Mississippi Lime	Dry	3306				

Describe in detail the manner in which the well was plugged, indicating where the mud fluid was placed and the method or methods used in introducing it into the hole. If cement or other plugs were used, state the character of same and depth placed, from feet to feet for each plug set.

Cement from 3355' to 3328.40'
Heavy mud inside 5 1/2" casing 3328.40' to 2435'
Heavy mud from 2435' to 162'
Cement from 162' to 117'
Heavy mud from 117' to 35'
Cement from 35' to bottom of cellar

(If additional description is necessary, use BACK of this sheet)

Correspondence regarding this well should be addressed to Kewanee Oil Company
Address Box 428, Shidler, Oklahoma

STATE OF Oklahoma, COUNTY OF Osage, ss.

Pat M. Welch

(employee of owner) or (owner or operator) of the above-described well,

being first duly sworn on oath, says: That I have knowledge of the facts, statements, and matters herein contained and the log of the above-described well as filed and that the same are true and correct. So help me God.

(Signature)

Pat M. Welch

Box 428, Shidler, Oklahoma

(Address)

SUBSCRIBED AND SWORN to before me this 9th day of February, 1954


Robert O. Whittack

Notary Public.

My commission expires 7-19-54

22-7377-S

4-49-10M

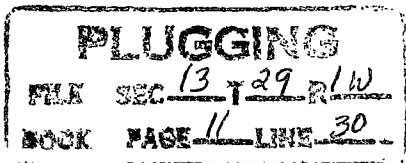

2-10-54

KEWANEE OIL COMPANY

Well Record: Roy # 1

Elevation: 1282' C.M.

Location: 330' from South and West lines of NE/4 Section 13, T-29-S, R-1-W, Sedgwick County, Kansas.

Drilling Commenced: 12-16-52

Drilling Completed: 1-8-53

Treatment Record: On 1-5-53 at depth of 3336' dumped 100 gal. mud acid and bailed back then acidized with 500 gal. Dowell XM-38 acid.

On 1-13-53 at depth of 3325' acidized with 1000 gal. type J 15% acid.

Production After Treatment: After 1st acid job swabbed 214.58 bbls. fluid in 16 hours - then next 14 hours swabbed 8.35 bbls. oil and 61.79 bbls. water.

After 2nd acid job swabbed 5.01 bbls. oil and 101.87 bbls. water 1st 12 hours after treatment.

C. M. FORMATION TOPS AS PICKED FROM SCHLUMBERGER LOG

Lansing	2414' -1132'
Kansas City	2750' -1168'
Mississippi Lime	3306' -2024'
First Stain	3329' -2047'

CASING RECORD

8-5/8" casing set at 167.74' C.M. and cemented with 200 sacks cement by Halliburton.


5-1/2" casing set at 3328.40' C.M. and cemented with 35 sacks cement by Halliburton.

FORMATION RECORD:

0 Surface	2700 Shale and lime
4 Cellar	2820 Lime and shale
30 Surface Soil and Clay	2906 Lime
70 Sand	2940 Lime and shale
128 Red and Blue shale	2985 Shale and lime
235 Shale and shells	3030 Lime and shale
450 Lime	3075 Shale and lime
675 Shale and Lime	3150 Lime and shale
840 Lime and shale	3280 Shale and lime
1385 Shale and shells	3305 Lime and shale
1740 Shale and lime	3336 Cherty lime
2080 Lime and shale	3339 Lime
2260 Shale and Lime	3355 Crystalline Fossiliferous Limestone
2660 Lime shale	3355 TOTAL DEPTH
2700 Shale and Lime	

SLOPE TESTS

Ran Slope Test at 500' and showed 0 degree deviation
 Ran Slope Test at 1000' and showed 0 degree deviation
 Ran Slope Test at 1500' and showed 0 degree deviation
 Ran Slope Test at 2000' and showed 0 degree deviation
 Ran Slope Test at 3000' and checked okay

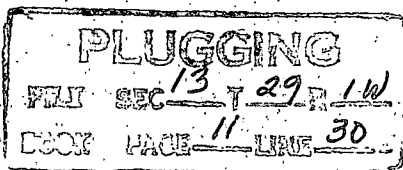Rec'd
2-10-54