


15-173-01690-0000

STATE OF KANSAS
STATE CORPORATION COMMISSION

Give All Information Completely
Make Required Affidavit
Mail or Deliver Report to:
Conservation Division
State Corporation Commission
211 No. Broadway
Wichita, Kansas

WELL PLUGGING RECORD

NORTH

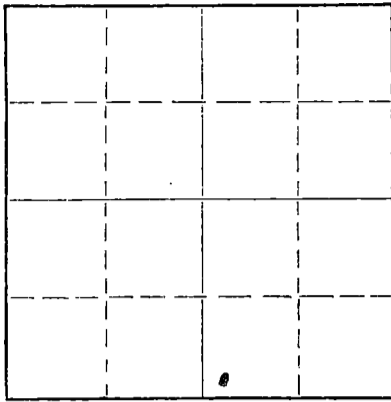

Locate well correctly on above
Section Plat

Sedgwick County. Sec. 13 Twp. 29S Rge. 1 (X) (W)
Location as "NE/CNW&SW¼" or footage from lines. SW-SW-SE
Lease Owner Joe E. Newman
Lease Name Emma Ray Well No. 1C
Office Address First National Bank Bldg., Denver, Co.
Character of Well (completed as Oil, Gas or Dry Hole) Oil
Date well completed Jan. 27 1957
Application for plugging filed 6-17 1959
Application for plugging approved 6-17 1959
Plugging commenced 6-17 1:00 P.M. 1959
Plugging completed 6-20 7:00 P.M. 1959
Reason for abandonment of well or producing formation stopped producing

If a producing well is abandoned, date of last production 6-10 1959
Was permission obtained from the Conservation Division or its agents before plugging was commenced? yes

Name of Conservation Agent who supervised plugging of this well Lee Guthrie
Producing formation Lime Depth to top 3353 Bottom 3354 Total Depth of Well 3354 Feet
Show depth and thickness of all water, oil and gas formations.

OIL, GAS OR WATER RECORDS

CASING RECORD

FORMATION	CONTENT	FROM	TO	SIZE	PUT IN	PULLED OUT
				8 5/8	230'	Circuaded
				5 1/2	3353	2303

Describe in detail the manner in which the well was plugged, indicating where the mud fluid was placed and the method or methods used in introducing it into the hole. If cement or other plugs were used, state the character of same and depth placed, from _____ feet to _____ feet for each plug set.

3346 dumped 5 sacks cement, dumped wet with bailer
250 10' rock bridge, dumped 15 sacks cement dry
Mudded to 35'
35' 5' rock bridge, dumped 10 sacks cement dry.

RECEIVED
STATE CORPORATION COMMISSION

JUL 14 1959 7-14-59

CONSERVATION DIVISION
Wichita, Kansas

(If additional description is necessary, use BACK of this sheet)
Name of Plugging Contractor Kent Well Servicing Company
Address Box 667, El Dorado, Kansas

STATE OF Kansas, COUNTY OF Butler, ss.

(employee of owner) or (owner or operator) of the above-described well, being first duly sworn on oath, says: That I have knowledge of the facts, statements, and matters herein contained and the log of the above-described well as filed and that the same are true and correct. So help me God.

(Signature) C. D. Payne

(Address)

SUBSCRIBED AND SWORN TO before me this 13 day of July, 1959

Evelene E. Phillips

Notary Public.

My commission expires June 18, 1963

PLUGGING
FILE SEC. 13 T. 29 R. 1W
BOOK PAGE 51 LINE 10