

DISTRICT CONSERVATION AGENT'S REPORT

TO:

State Corporation Commission  
Conservation Division  
800 Bitting Building  
Wichita, Kansas

FILE NO. 44-17  
LOCATION S 28-5E  
SEC. 30 TWP. 27 RGE. 10W

Dry Hole \_\_\_\_\_ Abandoned Oil Well \_\_\_\_\_ Abandoned Gas Well ✓


I have today completed supervision of plugging of:

Well No. 1 Lease 3 miles "G"  
Operator Shelly Oil Co Address Hutchinson Kans  
Field ✓ County Kingman  
Total Depth 4040 Feet.

(Describe briefly the manner in which the well was plugged)

Reported as previously P.B. to 3492  
and hole made solid at 3474' and  
6 sacks of cement dumped at 3474'  
and hole made solid at 300' and  
15 sacks of cement at 300' and 5 sk at top.  
The intervals between above plugs  
were mudded ~~with~~ with heavy mud.

30 27 10W  
44 17

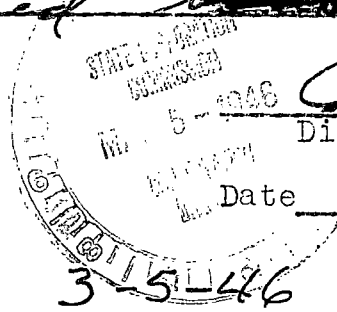

Paul Rourke  
District Conservation Agent  
Date 3-4-46