

CARD MUST BE TYPED

State of Kansas

CARD MUST BE SIGNED

NOTICE OF INTENTION TO DRILL

(see rules on reverse side)

Starting Date May 5 1987
month day year

API Number 15- 095-21,569-0000

OPERATOR: License # 4548
Name ONEOK Exploration Company
Address P. O. Box 871
City/State/Zip Tulsa, OK 74102-0871
Contact Person W. C. Southmayd, Jr.
Phone 918/588-7700

C N/2 NE Sec. 28 Twp. 27 S, Rg. 8W
4,620 Ft. from South Line of Section
1,320 Ft. from East Line of Section

(Note: Locate well on Section Plat on reverse side)

Nearest lease or unit boundary line 660 feet
County Kingman

CONTRACTOR: License # 5380
Name Eagle Delg. Inc
City/State Wichita, Ks

Lease Name Drumright Well # 1-28
Ground surface elevation 1,640 feet MSL

Well Drilled For: Well Class: Type Equipment:
 Oil SWD Infield Mud Rotary
 Gas Inj Pool Ext. Air Rotary
 OWWO Expl Wildcat Cable

Domestic well within 330 feet: yes no
Municipal well within one mile: yes no

Depth to bottom of fresh water 140
Depth to bottom of usable water 200

If OWWO: old well info as follows:

Surface pipe by Alternate: 1 2
Surface pipe planned to be set 250

Operator
Well Name
Comp Date Old Total Depth.....

Conductor pipe required
Projected Total Depth 4,700 feet
Formation Simpson

I certify that well will comply with K.S.A. 55-101, et seq., plus eventually plugging hole to KCC specifications. Manager,
Date 4/24/87 Signature of Operator or Agent Title Drilling & Production

For KCC Use:

Conductor Pipe Required feet; Minimum Surface Pipe Required 200 feet per Alt. ① &

This Authorization Expires 10-27-87 Approved By 4-27-87

[Handwritten signature]


Must be filed with the K.C.C. five (5) days prior to commencing well
This card void if drilling not started within six (6) months of date received by K.C.C.

Important procedures to follow:

1. Notify District office before setting surface casing.
2. Set surface casing by circulating cement to the top.
3. File completion forms ACO-1 with K.C.C. within 90 days of well completion, following instructions on ACO-1, side 1, and including copies of wireline logs.
4. Notify District office 48 hours prior to old well workover or re-entry.
5. Prior to filing Intent, prepare a proposed plugging plan in case well is D & A, then obtain approval of plan when calling district office prior to setting surface pipe.
6. Submit plugging report (CP-4) to K.C.C. after plugging is completed.
7. Obtain an approved injection docket number before disposing of salt water.
8. Notify K.C.C. within 10 days when injection commences or terminates.
9. If an alternate 2 completion, cement in the production pipe from below any usable water to surface within 120 days of spud date.

A Regular Section of Land
1 Mile = 5,280 Ft.

4-27-87

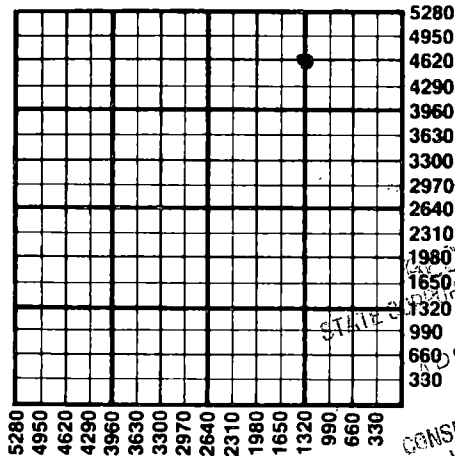

State Corporation Commission of Kansas
Conservation Division
200 Colorado Derby Building
Wichita, Kansas 67202
(316) 263-3238