

CARD MUST BE TYPED

State of Kansas  
**NOTICE OF INTENTION TO DRILL**  
(see rules on reverse side)

Corrected  
CARD MUST BE SIGNED  
12-21-84

Starting Date: ..... 12 ..... 21 ..... 84 .....  
month day year

API Number 15-095-21,512-00-00

OPERATOR: License # 5123  
Name Pickrell Drilling Company  
Address 110 N. Market, Suite 205  
City/State/Zip Wichita, KS 67202  
Contact Person Jay McNeil  
Phone (316) 262-8427

\*275' E. of NW, SE, SE Sec 32, Twp 27, S, Rge 6...  East  West  
(Location)  
\* 1015 Ft North from Southeast Corner of Section  
\* 720 Ft West from Southeast Corner of Section  
(Note: Locate well on Section Plat on reverse side)

CONTRACTOR: License # 5123  
Name Pickrell Drilling Company  
City/State Wichita, Kansas

Nearest lease or unit boundary line 990 feet.  
County Kingman  
Lease Name M & R Farms 'A' Well# 1

Well Drilled For: Well Class: Type Equipment:  
 Oil  Swd  Infield  Mud Rotary  
 Gas  Inj  Pool Ext.  Air Rotary  
 OWWO  Expl  Wildcat  Cable

Domestic well within 330 feet:  yes  no  
Municipal well within one mile:  yes  no

If OWWO: old well info as follows:  
Operator .....  
Well Name .....  
Comp Date ..... Old Total Depth .....  
Projected Total Depth 4300 feet  
Projected Formation at TD Viola  
Expected Producing Formations Miss, Viola

Depth to Bottom of fresh water ..... feet  
Lowest usable water formation Nippewalla  
Depth to Bottom of usable water 200 feet  
Surface pipe by Alternate: 1  2   
Surface pipe to be set 200+ feet  
Conductor pipe if any required N/A feet  
\* Ground surface elevation 1545 feet MSL  
This Authorization Expires 6-17-85  
Approved By 12-17-84

I certify that we will comply with K.S.A. 55-101, et seq., plus eventually plugging holes to K.C.C. specifications. *WRS* NWSESE 990 FSL 990 FEL


Date 12-19-84 Signature of Operator or Agent *[Signature]* Title Geologist

\*NOTE: Correction in location and elevation.

Must be filed with the K.C.C. five (5) days prior to commencing well  
 This card void if drilling not started within six (6) months of date received by K.C.C.

**Important procedures to follow :**

**A Regular Section of Land**  
**1 Mile = 5,280 Ft.**

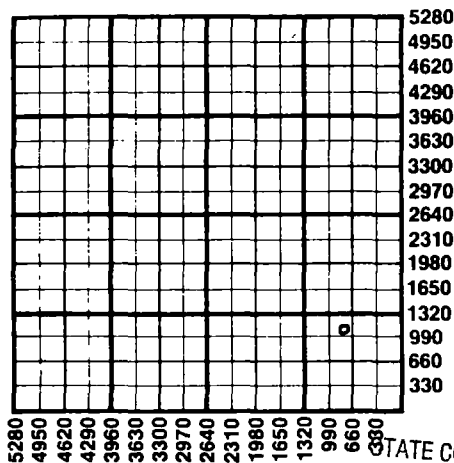

1. Notify District office before setting surface casing.
2. Set surface casing by circulating cement to the top.
3. File completion forms ACO-1 with K.C.C. within 90 days of well completion, following instructions on ACO-1, side 1, and including copies of wireline logs.
4. Notify District office 48 hours prior to old well workover or re-entry.
5. Prior to plugging, prepare a plugging plan, then obtain agreement from the appropriate district office for an approved plugging plan.
6. Submit plugging report (CP-4) to K.C.C. after plugging is completed.
7. Obtain an approved injection docket number before disposing of salt water.
8. Notify K.C.C. within 10 days when injection commences or terminates.
9. If an alternate 2 completion, cement in the production pipe from below any usable water to surface within 120 days of spud date.

RECEIVED

STATE CORPORATION COMMISSION

DEC 20 1984

CONSERVATION DIVISION  
 Wichita, Kansas

State Corporation Commission of Kansas  
 Conservation Division  
 200 Colorado Derby Building  
 Wichita, Kansas 67202  
 (316) 263-3238