

NOTICE OF INTENTION TO DRILL

(see rules on reverse side)

Starting Date 3 month 10 day 86 year

API Number 15- 095-21558-0000

OPERATOR: License # 5313
Name F & M OIL CO., INC.
Address 422 Union Center
City/State/Zip Wichita, Kansas 67202
Contact Person Ronald S. Schraeder
Phone (316)262-2636

C NW SE 27 Twp. 27 S, Rg. 5W
1980 Sec. 27 Twp. 27 S, Rg. 5W
1980 Ft. from South Line of Section
1980 Ft. from East Line of Section

(Note: Locate well on Section Plat on reverse side)

CONTRACTOR: License # 5103
Name Union Drilling Co., Inc.
City/State Wichita, Kansas 67202

Nearest lease or unit boundary line 1980 feet
County Kingman
Lease Name Young "I" Well # 1

Well Drilled For: Oil SWD Infield Mud Rotary
Gas Inj Pool Ext. Air Rotary
OWWO Expl Wildcat Cable

Ground surface elevation Unkown feet MSL
Domestic well within 330 feet: yes no
Municipal well within one mile: yes no
Surface pipe by Alternate: 1 X 2
Depth to bottom of fresh water 100
Depth to bottom of usable water 200
Surface pipe planned to be set 275
Projected Total Depth 3850 feet
Formation Mississippi

If OWWO: old well info as follows:

Operator
Well Name
Comp Date Old Total Depth

I certify that well will comply with K.S.A. 55-101, et seq., plus eventually plugging hole to KCC specifications.

cementing will be done immediately upon setting production casing.

Date 3-3-86 Signature of Operator or Agent X [Signature] Title Vice-President

For KCC Use:

Conductor Pipe Required feet; Minimum Surface Pipe Required 200 feet per Alt.
This Authorization Expires 9-5-86 Approved By [Signature]

Must be filed with the K.C.C. five (5) days prior to commencing well
This card void if drilling not started within six (6) months of date received by K.C.C.


Important procedures to follow:

RECEIVED
STATE CORPORATION COMMISSION Notify District office before setting surface casing.

A Regular Section of Land
1 Mile = 5,280 Ft.

MAR 5 1986
3-5-86
CONSERVATION DIVISION
Wichita, Kansas

2. Set surface casing by circulating cement to the top.
3. File completion forms ACO-1 with K.C.C. within 90 days of well completion, following instructions on ACO-1, side 1, and including copies of wireline logs.
4. Notify District office 48 hours prior to old well workover or re-entry.
5. Prior to filing Intent, prepare a proposed plugging plan in case well is D & A, then obtain approval of plan when calling district office prior to setting surface pipe.
6. Submit plugging report (CP-4) to K.C.C. after plugging is completed.
7. Obtain an approved injection docket number before disposing of salt water.
8. Notify K.C.C. within 10 days when injection commences or terminates.
9. If an alternate 2 completion, cement in the production pipe from below any usable water to surface within 120 days of spud date.

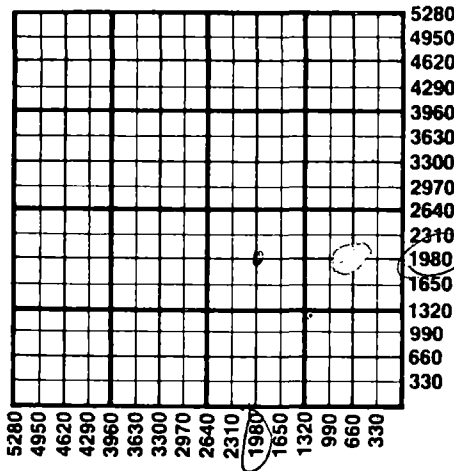

State Corporation Commission of Kansas
Conservation Division
200 Colorado Derby Building
Wichita, Kansas 67202
(316) 263-3238