


STATE OF KANSAS
STATE CORPORATION COMMISSION

Give All Information Completely
Make Required Affidavit
Mail or Deliver Report to:
Conservation Division
State Corporation Commission
211 No. Broadway
Wichita, Kansas

WELL PLUGGING RECORD

NORTH

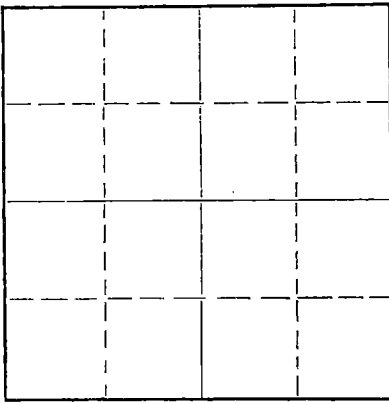

Locate well correctly on above
Section Plat

Stafford County. Sec. 20 Twp. 24S Rge. 14 (E) (W)
Location as "NE/CNW/SW" or footage from lines SE NW NE
Lease Owner WILKINSON DRILLING, INC.
Lease Name THUROW Well No. 1
Office Address 1121 Union National Building, Wichita 2, Kansas
Character of Well (completed as Oil, Gas or Dry Hole) Dry
Date well completed September 12, 19 58
Application for plugging filed September 12, 19 58
Application for plugging approved September 12, 19 58
Plugging commenced September 12, 19 58
Plugging completed September 12, 19 58
Reason for abandonment of well or producing formation No commercial quantity
of oil and/or gas was encountered.
If a producing well is abandoned, date of last production - 19
Was permission obtained from the Conservation Division or its agents before plugging was commenced? Yes

Name of Conservation Agent who supervised plugging of this well Frank Broadfoot of St. John, Kansas
Producing formation - Depth to top - Bottom - Total Depth of Well - Feet
Show depth and thickness of all water, oil and gas formations.

OIL, GAS OR WATER RECORDS

CASING RECORD

FORMATION	CONTENT	FROM	TO	SIZE	PUT IN	PULLED OUT
Sand	H ₂ O	160	200			

Describe in detail the manner in which the well was plugged, indicating where the mud fluid was placed and the method or methods used in introducing it into the hole. If cement or other plugs were used, state the character of same and depth placed, from feet to feet for each plug set.

Fill hole with heavy mud. Plugged at 300'. Topped with $\frac{1}{2}$ sack of hulls and 20 sacks of cement through drill pipe. Plugged at 35'. Topped with $\frac{1}{2}$ sack of hulls and 20 sacks of cement through drill pipe.

RECEIVED
STATE CORPORATION COMMISSION

OCT 28 1958

CONSERVATION DIVISION
Wichita, Kansas

(If additional description is necessary, use BACK of this sheet)

Name of Plugging Contractor WILKINSON DRILLING, INC.
Address 1121 Union National Building, Wichita 2, Kansas

STATE OF KANSAS, COUNTY OF SEDGWICK, ss.
WALTER M. WILKINSON

(employee of owner) or (owner or operator) of the above-described well, being first duly sworn on oath, says: That I have knowledge of the facts, statements, and matters herein contained and the log of the above-described well as filed and that the same are true and correct. So help me God.


(Signature) Walter M. Wilkinson
1121 Union Natl. Bldg. Wichita 2, Kans.
(Address)

SUBSCRIBED AND SWORN to before me this 23 day of October, 19 58

Carolyn F. Moore

Notary Public.

My commission expires Jan. 2, 1961

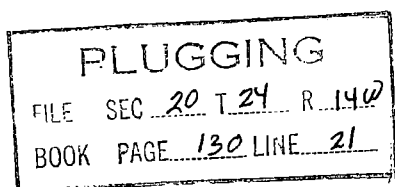

WILKINSON DRILLING, INC.

1121 Union National Building

Wichita 2, Kansas

October 23, 1958

THURON #1

Company - WILKINSON DRILLING, INC.
Contractor - Company Tools

Commenced - August 31, 1958
Completed - September 12, 1958
Total Depth - 4335'

Location - SE NW NE, Sec. 20-24s-14w,
Stafford County, Kansas.
Elevation - 1985' KB
Casing - 8 5/8" @ 345' w/250 sks Cmn. Cem

FIGURES INDICATE BOTTOMS OF FORMATIONS

<u>Depth</u>	<u>Formation</u>
0 - 35	Surface soil.
35 - 240	Sand and clay.
240 - 345	Shale.
345 - 575	Shale, shells, and red beds.
575 - 1840	Shale and shells.
1840 - 1975	Lime and shale.
1975 - 2115	Lime.
2115 - 2580	Lime and shale.
2580 - 3335	Shale and lime.
3335 - 3570	Lime and shale streaks.
3570 - 3676	Shale.
3676 - 4096	Lime and shale streaks.
4096 - 4143	Various colored shale and chert.
4143 - 4243	Dolomitic chert and lime.
4243 - 4254	Shale.
4254 - 4272	Sand.
4272 - 4286	Shale.
4286 - 4300	Sand.
4300 - 4325	Shale.
4325 - 4335	Dolomite.

RECEIVED
STATE CORPORATION COMMISSION

OCT 28 1958

CONSERVATION DIVISION
Wichita, Kansas

We hereby certify the above and foregoing to be a true and correct copy of the Log on the Thuron #1, located in the SE NW NE, Sec. 20-24s-14w, Stafford County, Kansas.

WILKINSON DRILLING, INC.

Charles M. Perkinson

Subscribed and sworn to before me this twenty-third day of October, nineteen hundred and fifty-eight.

Barbara F. Moore

My Commission expires January 2, 1961.

