


Give All Information Completely  
Make Required Affidavit  
Mail or Deliver Report to:  
Conservation Division  
State Corporation Commission  
211 No. Broadway  
Wichita, Kansas

WELL PLUGGING RECORD

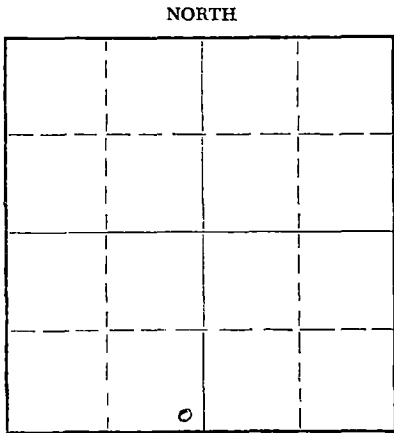

Locate well correctly on above  
Section Plat

Stafford County. Sec. 17 Twp. 24S Rge. 14 (E) W (W)  
Location as "NE/CNW $\frac{1}{4}$ /SW $\frac{1}{4}$ " or footage from lines SE SE SW  
Lease Owner Anschutz Drilling Co., Inc.  
Lease Name Laudick Well No. 1  
Office Address 709 Union Natl. Bank Bldg., Wichita, Kansas  
Character of Well (completed as Oil, Gas or Dry Hole) Dry Hole  
Date well completed July 18 1956  
Application for plugging filed July 18 1956  
Application for plugging approved July 18 1956  
Plugging commenced July 19 1956  
Plugging completed July 19 1956  
Reason for abandonment of well or producing formation Dry

If a producing well is abandoned, date of last production \_\_\_\_\_ 19\_\_\_\_  
Was permission obtained from the Conservation Division or its agents before plugging was commenced? Yes

Name of Conservation Agent who supervised plugging of this well R. M. Brundage  
Producing formation \_\_\_\_\_ Depth to top \_\_\_\_\_ Bottom \_\_\_\_\_ Total Depth of Well 4350 Feet  
Show depth and thickness of all water, oil and gas formations.

OIL, GAS OR WATER RECORDS

CASING RECORD

FORMATION	CONTENT	FROM	TO	SIZE	PUT IN	PULLED OUT
				8-5/8"	272'	

Describe in detail the manner in which the well was plugged, indicating where the mud fluid was placed and the method or methods used in introducing it into the hole. If cement or other plugs were used, state the character of same and depth placed, from \_\_\_\_\_ feet to \_\_\_\_\_ feet for each plug set.

Bottom plug @ 240' with 20 sacks cement.  
Top plug @ 35' with 10 sacks cement.

(If additional description is necessary, use BACK of this sheet)

Name of Plugging Contractor Anschutz Drilling Co., Inc.  
Address 709 Union Natl. Bank Bldg., Wichita, Kansas

STATE OF Kansas, COUNTY OF Sedgwick, ss.  
Shirley Salley (employee of owner) or (owner or operator) of the above-described well, being first duly sworn on oath, says: That I have knowledge of the facts, statements, and matters herein contained and the log of the above-described well as filed and that the same are true and correct. So help me God.

(Signature) Shirley Salley  
709 Union Natl. Bank Bldg., Wichita, Kansas  
(Address)

SUBSCRIBED AND SWORN to before me this 23rd day of July 1956

Kenneth R. Stevenson  
Notary Public.

My commission expires April 27, 1959

PLUGGING  
FILE SEC 17 T 24 R 14W  
BOOK PAGE 82 LINE 17

RECEIVED  
STATE CORPORATION COMMISSION

JUL 25 1956 7-25-56

CONSERVATION DIVISION  
Wichita, Kansas

DRILLERS' LOG

ANSCHUTZ DRILLING CO., INC.  
 #1 LAUDICK  
 SE SE SW Sec. 17-24S-14W  
 Stafford County, Kansas

<u>FROM</u>	<u>TO</u>	
0	262	Red bed
262	560	Red bed and shale
560	1920	Shale
1920	2675	Lime and shale
2675	2835	Shale
2835	3160	Shale and lime
3160	3275	Lime
3275	3345	Shale and lime
3345	3630	Lime
3630	3750	Lime and shale
3750	3989	Lime
3989	4136	Lime, shale and chert
4136	4177	Shale and chert
4177	4230	Viola
4230	4254	Lime and chert
4254	4295	Viola
4295	4333	Lime and shale
4333	4350	Arbuckle lime
	4350	Rotary Total Depth

COMMENCED: 7/4/56

COMPLETED: 7/18/56

CASING RECORD:

Set 272' of 8-5/8" surface casing with 175 sacks cement, 2% gel., 200# calcium chloride.

STATE OF KANSAS )  
 ) SS  
 COUNTY OF SEDGWICK )

I hereby affirm that the above and foregoing is a true and correct copy of the formations encountered on the #1 Laudick, SE SE SW Section 17-24S-14W, Stafford County, Kansas, as reflected by the daily drilling reports.

ANSCHUTZ DRILLING CO., INC.

By: *Shirley Salley*  
 Shirley Salley

Subscribed and sworn to before me this 24th day of July, 1956.

My Commission Expires: April 27, 1959

*Kenneth R. Swenson*  
 Kenneth R. Swenson, Notary Public

**PLUGGING**  
 FILE SEC 17 T 24 R 14W  
 BOOK PAGE 82 LINE 17

REC  
 STATE OF KANSAS

CONSULTANTS  
 NOTARY PUBLIC

7-25-56