

STATE OF KANSAS  
STATE CORPORATION COMMISSION

Form CP-4

Give All Information Completely  
Make Required Affidavit  
Mail or Deliver Report to:  
Conservation Division  
State Corporation Commission  
212 No. Market  
Wichita, Kansas

WELL PLUGGING RECORD

Stafford County, Sec. 17 Twp. 24s Rge. (E) 14 (W)

Location as "NE/CNW%SW%" or footage from lines C N/2 SE SE

Lease Owner SANTA-FE PIPE & SUPPLY, INC.,

Lease Name DENKER Well No. 2

Office Address BOX 562, GREAT BEND, KANSAS

Character of Well (completed as Oil, Gas or Dry Hole) oil

Date well completed JULY 25 1966

Application for plugging filed APRIL 25 1967

Application for plugging approved APRIL 28 1967

Plugging commenced MAY 29 1967


Plugging completed JUNE 11 1967

Reason for abandonment of well or producing formation DEPLETED

If a producing well is abandoned, date of last production 19

Was permission obtained from the Conservation Division or its agents before plugging was commenced?

NORTH

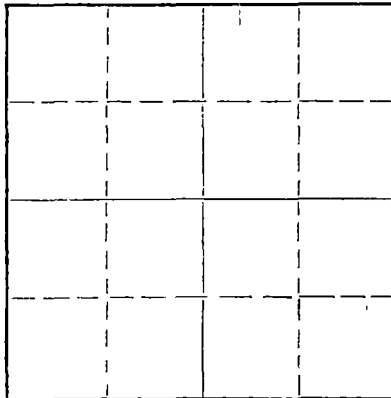

Locate well correctly on above Section Plat

Name of Conservation Agent who supervised plugging of this well

Producing formation Depth to top Bottom Total Depth of Well 4310' Feet

Show depth and thickness of all water, oil and gas formations.

OIL, GAS OR WATER RECORDS

CASING RECORD

FORMATION	CONTENT	FROM	TO	SIZE	PUT IN	PULLED OUT
				10-3/4"	209'	none
				7"	4304'	2194.53'

Describe in detail the manner in which the well was plugged, indicating where the mud fluid was placed and the method or methods used in introducing it into the hole. If cement or other plugs were used, state the character of same and depth placed, from feet to feet for each plug set.

- 4310' - 3960' - plug
- 3960' - 3750' - sand
- 3750' - 3715' - 7 sacks cement
- 3715' - 200' - mud
- 200' - 190' - rock bridge
- 190' - 168' - 9 sacks cement
- 168' - 115' - 21 sacks cement
- 115' - 42' - mud
- 42' - 37' - rock bridge
- 37' - base - 15 sacks cement

(If additional description is necessary, use BACK of this sheet)

Name of Plugging Contractor Santa-Fe Pipe & Supply, Inc.,

Address Box 562, Great Bend, Kansas

STATE OF KANSAS, COUNTY OF BARTON, ss.

T. L. NUTT (employer or owner) or (owner or operator) of the above-described well, being first duly sworn on oath, says: That I have knowledge of the facts, statements, and matters herein contained and the log of the above-described well as filed and that the same are true and correct. So help me God.


(Signature) [Handwritten Signature]

BOX 562, GREAT BEND, KANSAS (Address)

SUBSCRIBED AND SWORN TO before me this 24th day of JUNE, 1967,

[Handwritten Signature] Notary Public.

My commission expires JULY 31, 1970

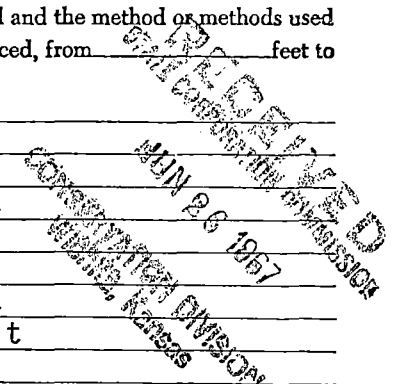

NO. 2-A DUNKERWELL LOG

Location: Ctr N/2 SE SE, 17-24S-11W  
Stafford County, Kansas

Commenced: July 10, 1956

Operator: Natural Gas and Oil Company  
Route 1, Great Bend, Kansas

Completed: July 25, 1956 (w/rty)

Elevation: 1984 KB (1979 Gr)

Contractor: Messman-Rimbart Drilling Company  
501 Petroleum Bldg., Wichita, Kansas

Production:

Casing Records: 10 3/4" @ 209' w/200 sx con.  
7" @ 430h' w/125 sx con.

.....L O G.....

Surface Clay-Sand	90
Shale-Shells	210
Shale	925
Anhydrite	944
Shale	1205
Shale-Shells	1560
Shale-Lime	1940
Lime-Shale	2100
Lime-Shale	2204
Shale-Lime	2330
Lime-Shale	2760
Shale	2927
Lime-Shale	3178
Shale-Lime	3258
Lime-Shale	3635
Shale-Lime	3730
Lime-Shale	3785
Lime	4081
Lime-Chert	4117
Viola (Lime-Chert)	4162
Viola Chert	4184
Lime	4236
Lime-Sand-Chert-Shale	4274
Simpson	4299
Artuckle	4302
Coring Artuckle	4310 R.T.D.

RECEIVED  
STATE CORPORATION COMMISSION

APR 28 1967

CONSERVATION DIVISION  
Wichita, Kansas

The undersigned, MESSMAN-RIMBART DRILLING COMPANY, hereby certifies that the above log is a true and correct log of the formation encountered in drilling the above well as reflected by the Daily Drilling Report.

MESSMAN-RIMBART DRILLING COMPANY

By: J. L. Gilliland  
J. L. Gilliland

Subscribed and sworn to before me  
this 6th day of August, 1956.

Juanita L. Davis  
Notary Public

My Commission Expires: November 5, 1958