

15-05-22244-00-00

STATE OF KANSAS
STATE CORPORATION COMMISSION

WELL PLUGGING RECORD

Give All Information Completely
Make Required Affidavit
Mail or Deliver Report to
Conservation Division
State Corporation Comm.
245 North Water
Wichita, KS 67202

Butler County, Sec. 28 Twp. 27S Rge. 6 E
Location as "NE/CNW $\frac{1}{4}$ SW $\frac{1}{4}$ " or footage from lines
1350' FSL 945' FWL SW/4

Lease Owner Range Oil Company, Inc.
Lease Name Simmons "A" Well No. 4


Office Address 240 Page Court, 220 W. Douglas, Wichita, Kansas
Character of Well (Completed as Oil, Gas or Dry Hole)
Dry Hole

Date Well completed 1-16 1983
Application for plugging filed 1-16 1983
Application for plugging approved 1-16 1983
Flugging commenced 1-16 1983
Plugging completed 1-16 1983

Reason for abandonment of well or producing formation
Dry Hole
If a producing well is abandoned, date of last production
19

Was permission obtained from the Conservation Division or
its agents before plugging was commenced? Yes

Name of Conservation Agent who supervised plugging of this well Ron Wilson
Producing formation Depth to top Bottom Total Depth of Well 3127
Show depth and thickness of all water, oil and gas formations.

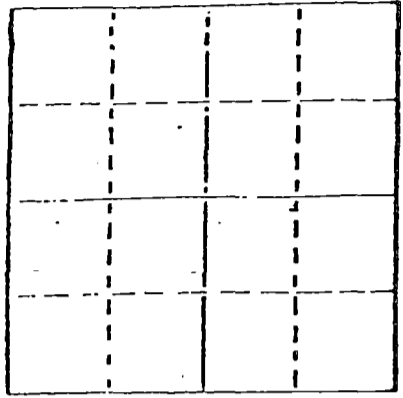

Locate well correctly on above
Section Plat

OIL, GAS OR WATER RECORDS

CASING RECORD

FORMATION	CONTENT	FROM	TO	SIZE	PUT IN	PULLED OUT
				8-5/8	210	0

Describe in detail the manner in which the well was plugged, indicating where the mud fluid
was placed and the method or methods used in introducing it into the hold. If cement or other
plugs were used, state the character of same and depth placed, from feet to
feet for each plug-set.

Filled Hole with mud
Spotted 35 sx cement @ 240'
Spotted 25 sx cement @ 60' w/plug
Spotted 10 sx cement in rat hole

United Cementing Ticket #2531

(If additional description is necessary, use BACK of this sheet)



Name of Plugging Contractor Range Drilling Company, Inc.

STATE OF Kansas COUNTY OF Sedgwick, ss.
Gary L. Reed (employee of owner) or (owner or operator
of the above-described well, being first duly sworn on oath, says: That I have knowledge of
the facts, statements, and matters herein contained and the log of the above-described well
is filed and that the same are true and correct. So help me God.

(Signature) Gary L. Reed
240 Page Court, 220 W. Douglas, Wichita, Kansas
(Address)

SUBSCRIBED AND SWORN TO before me this 26th day of January, 1983

Nora S. Davidson
Notary Public.

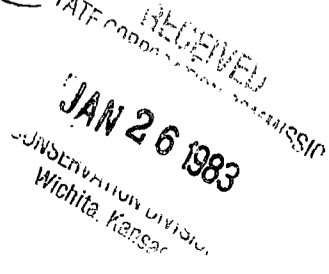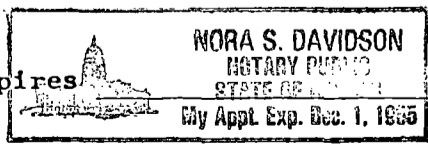

My commission expires