


Give All Information Completely  
Make Required Affidavit  
Mail or Deliver Report to:  
Conservation Division  
State Corporation Commission  
800 Biting Building  
Wichita, Kansas

OR  
FORMATION PLUGGING RECORD

Strike out upper line  
when reporting plug-  
ging off formations.

NORTH

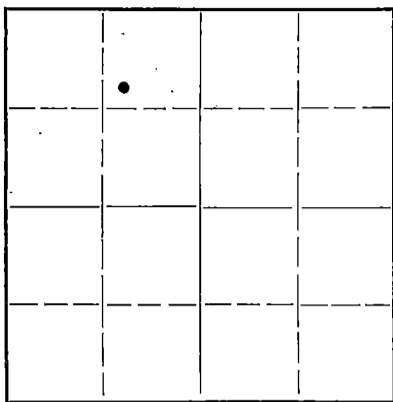

Locate well correctly on above  
Section Plat

Butler County, Sec. 28, Twp. 27, Rge. 6 (E) E (W)  
Location as "NE 1/4 NW 1/4 SW 1/4" or footage from lines SE 1/4 NE 1/4 NW 1/4 28-27-6E  
Lease Owner Bennett, Abels & El Dorado Refining Co  
Lease Name Shriver Well No. 1-B  
Office Address P.O. Box 731 - El Dorado, Kansas.  
Character of Well (completed as Oil, Gas or Dry Hole) Dry Hole  
Date well completed November 21st., 19 45  
Application for plugging filed November 30, 1945 19 45  
Application for plugging approved 19  
Plugging commenced November 23rd., 19 45  
Plugging completed November 25th 19 45  
Reason for abandonment of well or producing formation  
Dry Hole  
If a producing well is abandoned, date of last production 19  
Was permission obtained from the Conservation Division or its agents before plugging was com-  
menced? Yes

Name of Conservation Agent who supervised plugging of this well A. L. Loman  
Producing formation Depth to top Bottom Total Depth of Well 3041 Feet  
Show depth and thickness of all water, oil and gas formations.

OIL, GAS OR WATER RECORDS

CASING RECORD

| Formation | Content | From | To | Size    | Put In | Pulled Out |
|-----------|---------|------|----|---------|--------|------------|
|           |         |      |    | 15 1/2" | 26'    | None       |
|           |         |      |    | 12 1/2" | 625'   | 625'       |
|           |         |      |    | 10"     | 1637'  | 1637'      |
|           |         |      |    | 8 1/4"  | 2660'  | 2660'      |

Describe in detail the manner in which the well was plugged, indicating where the mud fluid was placed and the method or methods used in introducing it into the hold. If cement or other plugs were used, state the character of same and depth placed, from feet to feet for each plug set.

Mudded to 180'  
15 Sx. Cement on 20' rock bridge at 160'  
Mudded to 15'  
5 Sx. Cement on 10' rock bridge  
Filled to surface.

Copy of Well Log Attached

(If additional description is necessary, use BACK of this sheet)

Correspondence regarding this well should be addressed to Central Drilling Company  
Address 627 North Main St.  
El Dorado, Kansas.

STATE OF KANSAS, COUNTY OF BUTLER, ss.  
Dave Abels (employee of owner) or (owner or operator) of the above-described well,  
being first duly sworn on oath, says: That I have knowledge of the facts, statements, and matters herein contained and the log of the above-  
described well as filed and that the same are true and correct. So help me God.

(Signature) *Dave Abels*  
El Dorado, Kansas. (Address) Partner

SUBSCRIBED AND SWORN to before me this 1st day of December, 19 45.

My commission expires

*Notary Public*  
NOTARY PUBLIC

WESTERN PIPE AND SUPPLY CO.

P. O. BOX #731

EL DORADO, KANSAS

LOG

DESCRIPTION SE/4 NE/4 NW/4 28-27-6E

State Kansas

Company Bennett, Abels, Eld. Refg.

County Butler

Farm Shriver Well No. 2

Survey

T.

R.

Contractor Central Drilling Co

Commenced Oct. 23, 1945

Completed Nov. 21, 1945

Remarks Dry Hole

Altitude

Production

CASING RECORD

10 " 1637'

8 1/4 " 2660'

20 " 6 5/8 "

15 1/2 " 26' 5 3/16 "

12 1/2 " 625'

Shot Quarts Between

Log—Continued

Top

Bottom

Formation and Remarks

645 Shade Blue

710 Shale & Shells

715 Lime

745 Shale

790 Lime

810 Shale

815 Lime

820 Red Rock

920 Shale 1/2 HWE 915

940 Shale 2 BW @ 935

965 Lime

970 Shale

985 Lime

1040 Shale

1085 Lime

1090 Shale

1125 Lime

1140 Shale DEC 3-1945

1225 Lime

1235 Shale

1250 Lime

1275 Shale & Shells

1280 Shale


1285 Lime

1295 Shale

1315 Lime

STANDARD FORM 189  
MID-WEST PTG. CO., TULSA, OKLA.

| Top | Bottom | Formation and Remarks  |
|-----|--------|------------------------|
|     | 8      | Cellar                 |
|     | 20     | Soil                   |
|     | 25     | Gravel                 |
|     | 35     | Shale                  |
|     | 50     | Lime                   |
|     | 60     | Shale 12 BWFH @ 65'    |
|     | 65     | Lime                   |
|     | 115    | Shale                  |
|     | 130    | Lime                   |
|     | 140    | Shale                  |
|     | 160    | Lime                   |
|     | 180    | Shale                  |
|     | 190    | Lime                   |
|     | 200    | Shale                  |
|     | 215    | Lime                   |
|     | 220    | Red Rock               |
|     | 225    | Shale                  |
|     | 230    | Lime                   |
|     | 240    | Shale                  |
|     | 245    | Lime                   |
|     | 250    | Shale                  |
|     | 260    | Lime                   |
|     | 265    | Shale                  |
|     | 280    | Lime                   |
|     | 290    | Shale                  |
|     | 340    | Lime                   |
|     | 345    | Shale                  |
|     | 350    | Lime                   |
|     | 365    | Shale                  |
|     | 370    | Lime                   |
|     | 405    | Shale & Shells         |
|     | 480    | Shale                  |
|     | 485    | Red Rock               |
|     | 495    | Shale                  |
|     | 500    | Lime                   |
|     | 510    | Red Rock               |
|     | 520    | Shale                  |
|     | 530    | Shale FILE 28 27-6E    |
|     | 535    | Lime BOOK PAGE 34 - 27 |
|     | 545    | Shale                  |
|     | 550    | Lime                   |
|     | 565    | Shale                  |
|     | 620    | Shale Sandy HFW        |

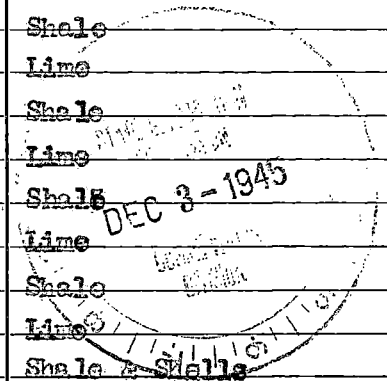

LOG—Continued

LOG—Continued

| Top | Bottom | Formation and Remarks | Top | Bottom | Formation and Remarks |
|-----|--------|-----------------------|-----|--------|-----------------------|
|     | 1345   | Shale                 |     |        |                       |
|     | 1350   | Lime                  |     |        |                       |
|     | 1365   | Shale                 |     |        |                       |
|     | 1415   | Lime                  |     |        |                       |
|     | 1430   | Shale                 |     |        |                       |
|     | 1450   | Lime                  |     |        |                       |
|     | 1455   | Shale                 |     |        |                       |
|     | 1470   | Broken Lime           |     |        |                       |
|     | 1570   | Shale                 |     |        |                       |
|     | 1575   | Lime                  |     |        |                       |
|     | 1605   | Shale                 |     |        |                       |
|     | 1615   | Lime                  |     |        |                       |
|     | 1625   | Shale                 |     |        |                       |
|     | 1650   | Lime                  |     |        |                       |
|     | 1705   | Shale                 |     |        |                       |
|     | 1885   | Lime 1 1/2 HW @ 1765' |     |        |                       |
|     | 2035   | Shale                 |     |        |                       |
|     | 2225   | Lime 1/2 HW @ 2115'   |     |        |                       |
|     | 2230   | Shale                 |     |        |                       |
|     | 2255   | Lime                  |     |        |                       |
|     | 2280   | Shale                 |     |        |                       |
|     | 2290   | Lime                  |     |        |                       |
|     | 2320   | Shale                 |     |        |                       |
|     | 2350   | Lime                  |     |        |                       |
|     | 2395   | Shale                 |     |        |                       |
|     | 2410   | Lime                  |     |        |                       |
|     | 2420   | Shale                 |     |        |                       |
|     | 2460   | Lime                  |     |        |                       |
|     | 2480   | Shale                 |     |        |                       |
|     | 2490   | Lime                  |     |        |                       |
|     | 2505   | Shale                 |     |        |                       |
|     | 2510   | Lime                  |     |        |                       |
|     | 2525   | Shale                 |     |        |                       |
|     | 2535   | Lime                  |     |        |                       |
|     | 2575   | Shale                 |     |        |                       |
|     | 2580   | Red Rock              |     |        |                       |
|     | 2590   | Lime                  |     |        |                       |
|     | 2610   | Shale                 |     |        |                       |
|     | 2615   | Red Rock              |     |        |                       |
|     | 2635   | Shale                 |     |        |                       |
|     | 2645   | Lime                  |     |        |                       |
|     | 2655   | Shale                 |     |        |                       |
|     | 2660   | Red Rock              |     |        |                       |
|     | 2665   | Shale                 |     |        |                       |
|     | 2710   | Lime                  |     |        |                       |
|     | 2735   | Shale                 |     |        |                       |
|     | 2955   | Lime                  |     |        |                       |
|     | 3025   | Shale                 |     |        | SSO & 2HW @ 2760'     |
|     | 3041   | Viola Lime T.D.       |     |        | HW @ 3030'            |
|     | 3041   | Total Depth           |     |        | SSO @ 3026'           |