


STATE OF KANSAS
STATE CORPORATION COMMISSION

Form CP-4

Give All Information Completely
Make Required Affidavit
Mail or Deliver Report to:
Conservation Division
State Corporation Commission
212 No. Market
Wichita, Kansas 67202

WELL PLUGGING RECORD

Stafford County. Sec. 11 Twp. 24 Rge. 15 (E) W (W)
Location as "NE/CNW%SW%" or footage from lines SW/4 SW/4 NW/4
Lease Owner Midwestern Supply Co., Inc.
Lease Name Harkness Well No. # 1
Office Address 710 Union Nat. Bldg.; Wichita, Ks. 67202
Character of Well (completed as Oil, Gas or Dry Hole) _____
Date well completed _____ 19____
Application for plugging filed _____ February 19 71
Application for plugging approved _____ February 19 71
Plugging commenced _____ February 18 19 71
Plugging completed _____ March 26 19 71
Reason for abandonment of well or producing formation _____

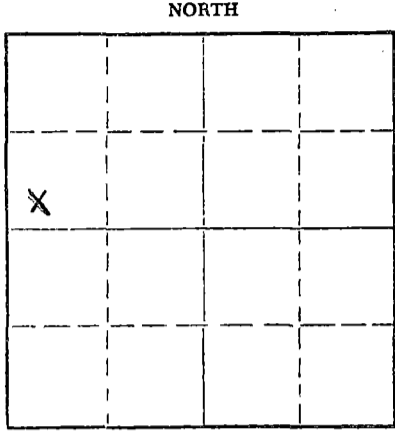

Locate well correctly on above Section Plat

If a producing well is abandoned, date of last production _____ 19____
Was permission obtained from the Conservation Division or its agents before plugging was commenced? Yes

Name of Conservation Agent who supervised plugging of this well Russell Biberstein
Producing formation _____ Depth to top _____ Bottom _____ Total Depth of Well _____ Feet
Show depth and thickness of all water, oil and gas formations.

OIL, GAS OR WATER RECORDS

CASING RECORD

FORMATION	CONTENT	FROM	TO	SIZE	PUT IN	PULLED OUT
				8 5/8	220	None
				4 1/2	4049	2204

Describe in detail the manner in which the well was plugged, indicating where the mud fluid was placed and the method or methods used in introducing it into the hole. If cement or other plugs were used, state the character of same and depth placed, from _____ feet to _____ feet for each plug set.

February 18, 1971 Plugged off bottom. Dumped sand to 3700'. Mixed and dumped 4 sx of cement to 3650'.
March 26, 1971 Plugged off top. Allied Cementing Co. mixed and pumped down 8 5/8" surface casing: 2 sx of hulls, 15 sx of gel and 100 sx of cement.

RECEIVED
STATE CORPORATION COMMISSION
APR 15 1971
CONSERVATION DIVISION
Wichita, Kansas
4-15-71

(If additional description is necessary, use BACK of this sheet)

Name of Plugging Contractor RUSS CASING PULLING, INC.
Address P. O. Box 1082 ; Great Bend, Kansas 67530

STATE OF Kansas, COUNTY OF Sedgwick, ss.
Robert M. Brentlinger (~~employee of owner~~) or (owner or operator) of the above-described well, being first duly sworn on oath, says: That I have knowledge of the facts, statements, and matters herein contained and the log of the above-described well as filed and that the same are true and correct. So help me God.

(Signature) [Signature]
207 Brown Bldg (Address)
19 71

Sworn to before me this 15th day of April, 19 71
Terry J. Gresham
Terry J. Gresham Notary Public.
March 11, 1973
My commission expires _____



COPY

WELL LOG BUREAU—KANSAS GEOLOGICAL SOCIETY
508 East Murdock, Wichita, Kansas


Company- WILKINSON DRILLING, INC.
Farm- Harkness No. 1

SEC. 11 T. 24 R. 15W
SW SW NW

Total Depth. 4050'
Comm. 4-28-60 Comp. 5-8-60

County Stafford
KANSAS

Shot or Treated.
Contractor. Wilkinson Drilling, Inc.
Issued. 8-13-60

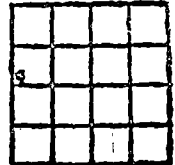

CASING:

8 5/8" @ 220' w/185 sks. cem.
4 1/2" @ 4049' w/175 sks. cem.

Elevation. 2018'

Production. 3,000 BOPD

Figures indicate Bottom of Formations.

sand, shale & shells	220
shale, shells & red bed	933
Anhydrite	955
shale & shells	1760
shale & lime	1925
lime & shale	2073
lime	2263
lime & shale	2390
shale & lime	2525
lime & shale	3469
shale	3475
lime	3480
shale	3488
lime	3512
shale	3606
lime & shale strks.	3966
vari-colored shale & chert	3979
chert	3993
shale & sand	4022
Arbuckle dolomite	4050
Total Depth	

SCOUT TOPS:

Heebner	3496
Douglas	3512
Brown Lime	3606
Lansing	3614
Base Kansas City	3917
Conglomerate	3966
Viola	3979
Simpson	3993
Arbuckle	4022

RECEIVED
STATE CORPORATION COMMISSION
FEB 10 1971
CONSERVATION DIVISION
Wichita, Kansas