


Give All Information Completely
Make Required Affidavit
Mail or Deliver Report to:
Conservation Division
State Corporation Commission
800 Bittling Building
Wichita, Kansas

WELL PLUGGING RECORD

NORTH

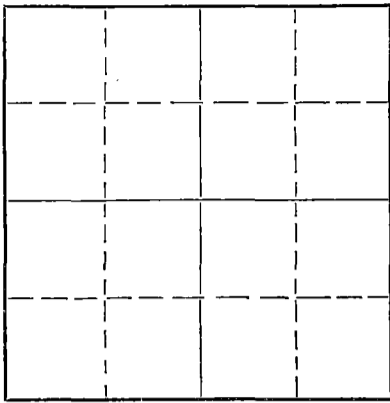

Locate well correctly on above
Section Plat

Kingman County. Sec. 27 Twp. 27 Rge. 5 (E) W(W)
Location as "NE/CNW/SW" or footage from lines C of W/2 NW NW
Lease Owner Bankoff Oil Company
Lease Name Henson Well No. 1
Office Address 823 N. Lewis - Tulsa, Oklahoma
Character of Well (completed as Oil, Gas or Dry Hole) Dry Hole
Date well completed June 16 19 54
Application for plugging filed June 16 19 54
Application for plugging approved June 16 19 54
Plugging commenced June 16 19 54
Plugging completed June 16 19 54
Reason for abandonment of well or producing formation Dry Hole

If a producing well is abandoned, date of last production 19
Was permission obtained from the Conservation Division or its agents before plugging was commenced? Yes

Name of Conservation Agent who supervised plugging of this well Ruel Durkee Box 597 McPherson, Kansas
Producing formation _____ Depth to top _____ Bottom _____ Total Depth of Well _____ Feet
Show depth and thickness of all water, oil and gas formations.

OIL, GAS OR WATER RECORDS

CASING RECORD

FORMATION	CONTENT	FROM	TO	SIZE	PUT IN	PULLED OUT
				8 5/8"	206'	

Describe in detail the manner in which the well was plugged, indicating where the mud fluid was placed and the method or methods used in introducing it into the hole. If cement or other plugs were used, state the character of same and depth placed, from _____ feet to _____ feet for each plug set.

Plug #1 set at 210' with 1/2 sacks hulls and 15 sacks of cement.
Plug #2 set at 40' with 1/2 sack hulls and 10 sacks cement.

(If additional description is necessary, use BACK of this sheet)

Name of Plugging Contractor Anschutz Drilling Co., Inc.
Address 706 Union National Bank Building

STATE OF Kansas, COUNTY OF Sedgwick, ss.
E. G. Koelling (employee of owner) or (owner or operator) of the above-described well, being first duly sworn on oath, says: That I have knowledge of the facts, statements, and matters herein contained and the log of the above-described well as filed and that the same are true and correct. So help me God.

(Signature) *E. G. Koelling*
706 Union National Bank Building
(Address)

SUBSCRIBED AND SWORN TO before me this 23rd day of June 19 54

My commission expires March 21, 1955.

Oliver Carter
RECEIVED Notary Public.
STATE CORPORATION COMMISSION

24-7368-S 3-53-20M

PLUGGING
FILE SEC 27 TWP 27 R 5W
BOOK PAGE 41 LINE 13

JUN 25 1954
6-25-54
CONSERVATION DIVISION
Wichita, Kansas

15-095-01274-0000

DRILLER'S LOG

Bankoff Oil Company
Henson #1
C of W/2 NW NW 27-27-5
Kingman County, Kansas

<u>TO</u>	<u>FROM</u>	
0	40	Sand & Gravel
40	70	Shale; Sand & Gravel
70	210	Shale, Shells & Red Rock
210	765	Shale & Shells
765	1015	Lime & Shale
1015	1295	Shale & Lime
1295	1395	Lime & Shale
1395	1515	Shale & Lime
1515	1670	Lime & Shale
1670	2655	Shale & Lime
2655	2985	Lime & Shale
2985	3553	Lime
3553	3758	Lime & Shale
3758	3786	Mississippi Chert
3786	3800	Dolomite
	3800	ROTARY TOTAL DEPTH D & A

COMMENCED: 6-3-54
COMPLETED: 6-15-54

CASING RECORD:

Set 8 5/8" surface casing at
204' with 150 sacks of cement.

STATE OF KANSAS)
) SS
COUNTY OF SEDGWICK)

I hereby affirm that the above and foregoing is a true and correct copy of the log of the Henson #1 located C of W/2 NW NW of Section 27-27-5 Kingman County, Kansas.

ANSCHUTZ DRILLING CO., INC.

BY: E. G. Koelling
E. G. Koelling

Subscribed and sworn to before me this 17th day of June, 1954.

Oliver Carter
Notary Public

My Commission Expires: March 21, 1955.

PLUGGING
JUL 27 1954 27-27-5W
PAGE 4 LINE 13