


STATE OF KANSAS
STATE CORPORATION COMMISSION

Give All Information Completely
Make Required Affidavit
Mail or Deliver Report to:
Conservation Division
State Corporation Commission
212 No. Market
Wichita, Kansas

WELL PLUGGING RECORD

Kingman County. Sec. 29 Twp. 27S Rge. (EX) 5 (W)
Location as "NE/CNW&SW&" or footage from lines. NE NE NW
Lease Owner Wrico Drilling, Inc.
Lease Name Young Well No. 2
Office Address 6631 East Kellogg, Wichita, Kansas
Character of Well (completed as Oil, Gas or Dry Hole) Dry Hole
Date well completed January 20 19 67
Application for plugging filed Verbal Authority 19
Application for plugging approved Verbal Authority 19
Plugging commenced January 20 19 67
Plugging completed January 20 19 67
Reason for abandonment of well or producing formation
If a producing well is abandoned, date of last production 19
Was permission obtained from the Conservation Division or its agents before plugging was commenced? Yes

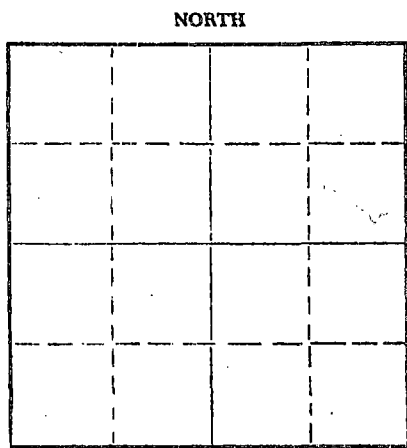

Locate well correctly on above
Section Plat

Name of Conservation Agent who supervised plugging of this well Archie V. Elving
Producing formation Depth to top Bottom Total Depth of Well Feet
Show depth and thickness of all water, oil and gas formations.

OIL, GAS OR WATER RECORDS

CASING RECORD

FORMATION	CONTENT	FROM	TO	SIZE	PUT IN	PULLED OUT
				8-5/8"	207	None

Describe in detail the manner in which the well was plugged, indicating where the mud fluid was placed and the method or methods used in introducing it into the hole. If cement or other plugs were used, state the character of same and depth placed, from feet to feet for each plug set.
Filled hole with heavy rotary mud from 2500' (rotary total depth) to 200'. Set bottom plug at 200' and cemented with 26 sacks cement.
Filled hole with heavy rotary mud to 40'. Set plug at 40' and cemented with 11 sacks cement, 3 sacks cement in rathole.

RECEIVED
JAN 26 1967
1-26-67
CONSERVATION DIVISION
WICHITA, KANSAS

(If additional description is necessary, use BACK of this sheet)
Name of Plugging Contractor H-30, Inc.
Address 200 No. Main, Wichita, Kansas 67202

STATE OF KANSAS, COUNTY OF SEDGWICK, ss.
Arlo B. Romer (employee of owner) or (owner or operator) of the above-described well, being first duly sworn on oath, says: That I have knowledge of the facts, statements, and matters herein contained and the log of the above-described well as filed and that the same are true and correct. So help me God.

(Signature) Arlo B. Romer
200 No. Main, Wichita, Kansas
(Address)

SUBSCRIBED AND SWORN TO before me this 25th day of January, 19 67

My commission expires December 27, 1967
Maxine Lampe
Notary Public.

KANSAS GEOLOGICAL SOCIETY
KANSAS WELL LOG BUREAU - KANSAS WELL SAMPLE BUREAU
KANSAS GEOLOGICAL SOCIETY BUILDING
508 EAST MURDOCK - WICHITA, KANSAS

15-09520,003-0000

COMPANY Wrico Drilling, Inc.

SEC. 29 T.27S R. 5W

FARM Young NO. 2


LOC. NE NE NW

TOTAL DEPTH 2500'
COMM. 1/16/67 COMP. 1/20/67

COUNTY Kingman

SHOT OR TREATED
CONTRACTOR H-30, Inc.
ISSUED

KANSAS

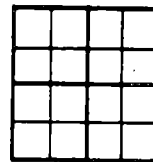

CASING

20 10
15 8 -5/8" @ 207' w/175 sx. cement
12 6
13 5

ELEVATION 1474 K.B.

PRODUCTION

FIGURES INDICATE BOTTOM OF FORMATIONS

Shale and Sandy Shale	70
Red Bed & Shale	130
Red Bed	162
Red Rock	207
Red Rock & Shale	740
Shale	800
Sand & Shale	1169
Shale, Shells & Lime	1338
Lime & Shale	2375
Lime	2500
Rotary Total Depth	2500

RECEIVED
STATE CORPORATION COMMISSION

JAN 26 1967

CONSERVATION DIVISION
Wichita, Kansas

I hereby certify the above and foregoing to be a true and correct log of the above described well, as shown by the drilling reports.

H-30, INC.

By Arlo B. Romer
Arlo B. Romer

STATE OF KANSAS }
SEDGWICK COUNTY } ss:

Subscribed and sworn to before me, a Notary Public in and for said county and state, this 25th day of January, 1967.

Maxine Lampe
Maxine Lampe - Notary Public

My Commission Expires:
December 27, 1967