


STATE OF KANSAS  
STATE CORPORATION COMMISSION

15-095-00057-0000

Give All Information Completely  
Make Required Affidavit  
Mail or Deliver Report to:  
Conservation Division  
State Corporation Commission  
211 No. Broadway  
Wichita, Kansas

WELL PLUGGING RECORD

NORTH

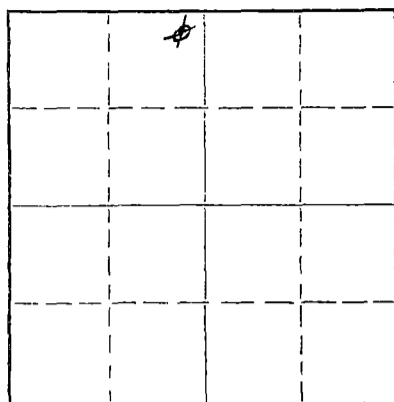

Locate well correctly on above  
Section Plat

Kingman County, Sec. 10 Twp. 27 Rge. 7 (E) (W)  
Location as "NE/CNW/SW" or footage from lines. NE NE NW  
Lease Owner Virginia Drlg Co Inc et al  
Lease Name McCutchen Well No. 1  
Office Address 712 Brown Bldg-Wichita 2, Kansas  
Character of Well (completed as Oil, Gas or Dry Hole) dry hole  
Date well completed May 13, 1955 19  
Application for plugging filed 4-5-57 19  
Application for plugging approved 4-8-57 19  
Plugging commenced 4-10-57 19  
Plugging completed 4-15-57 19  
Reason for abandonment of well or producing formation dry hole oil

If a producing well is abandoned, date of last production 8-19-56 19  
Was permission obtained from the Conservation Division or its agents before plugging was commenced? yes

Name of Conservation Agent who supervised plugging of this well M. A. Rives  
Producing formation Arbuckle Depth to top 4240 Bottom 4290 Total Depth of Well 4290 Feet  
Show depth and thickness of all water, oil and gas formations.

OIL, GAS OR WATER RECORDS

CASING RECORD

FORMATION	CONTENT	FROM	TO	SIZE	PUT IN	PULLED OUT
		0	193	8 5/8"	195.60	none
		gr	4214	5 1/2"	4209.64	2997 ft.

Describe in detail the manner in which the well was plugged, indicating where the mud fluid was placed and the method or methods used in introducing it into the hole. If cement or other plugs were used, state the character of same and depth placed, from \_\_\_\_\_ feet to \_\_\_\_\_ feet for each plug set.

3540 - 3490 - sand bridge  
3490 - 3465 5 sx cement  
Circ. 50 sx aquagel at 1600 ft.  
250 - 240 ~~XXXXXXXXXX~~ rock bridge  
240 - 180 20 sx cement  
180 - 35 mud  
35 to cellar 10 sx cement

(If additional description is necessary, use BACK of this sheet)

Name of Plugging Contractor R & S Pipe Pulling Co.  
Address Box 192 - Ellinwood, Kansas

STATE OF Kansas, COUNTY OF Sedgwick, ss.  
S. A. Murphy (employee of owner) or (owner or operator) of the above-described well, being first duly sworn on oath, says: That I have knowledge of the facts, statements, and matters herein contained and the log of the above-described well as filed and that the same are true and correct. So help me God.

(Signature) S. A. Murphy  
712 Brown Bldg.-Wichita 2, Kansas  
(Address)

SUBSCRIBED AND SWORN TO before me this 24th day of April 1957

My commission expires Febr. 5, 1961.

**RECEIVED**  
STATE CORPORATION COMMISSION  
Notary Public.

APR 25 1957

PLUGGING  
FILE SEC. 10 T. 27 R. 7W  
BOOK PAGE 4 LINE 31

15-095-00057-0000

Well: McCutcheon #1  
 Location: NE NE NW/4 Sec. 10-27-7, Kingman, Kansas  
 Company: Virginia Drilling Co., Inc. & Bay Petroleum Corporation  
 Contractor: Virginia Drilling Co., Inc.  
 Commenced: April 10, 1955  
 Completed: May 3, 1955 (Rotary Hole)  
 Total Depth: Rotary 4290'  
 Elevation: 1539 R. B.

FORMATION	DEPTH	
Surface clay-red rock-shale-shells	0-135	Set 8-5/8" csg @ 193' w/110 sz.
Shale-shells	135-1020	Set 5 1/2" csg @ 4214' w/250 sz.
Shale-lime	1020-1200	
Lime	1200-1455	
Broken lime	1455-1560	
Lime-shale	1560-1960	
Shale	1960-2000	
Shale-lime	2000-2820	
Sandy lime	2820-2845	
Lime	2845-2980	
Douglas-shale-sand-lime	2980-3106	
Kansas City Brown Lime	3106-3119	
K. C. White Lime	3119-3120	
Lime-hard	3120-3145	
Lime	3145-3270	
Lime-broken	3270-3320	
Lime	3320-3620	
Lime-shale	3620-3795	
Miss. Lime	3795-3836	
Miss. Lime-chart	3836-3909	
Cherty lime	3909-3930	
Shale-lime	3930-3968	
Kinderhook Shale	3968-4040	
<del>Shale-lime</del>	<del>4040-4080</del>	
Lime-shale	4040-4080	
Shale	4080-4107	
Viola	4107-4125	
Lime-sandy	4125-4148	
Sandy lime-shale	4148-4205	
Shale-lime	4205-4240	
Lime-Arbuckle	4240-4290	

TOPS:

Brown Lime	3106
<del>ILINA</del>	<del>3106</del>
Lansing	3118
Base Kansas City	3560
Mississippi	3791
Viola	4105
Simpson	4132
Arbuckle	4240

4/10/55  
 1539  
 2/4  
 2

PLUGGING  
 FILE SEC. 10 T. 27 R. 7W  
 BOOK PAGE 4 LINE 31

Now comes S. A. Murphy, who states that he is familiar with the drilling of oil and gas wells, and knows of his own knowledge that the McCutcheon #1, located in the NE NE NW/4 Section 10-27-7, Kingman County, Kansas, was drilled to a total depth of 4290 feet.

*S. A. Murphy*  
 S. A. Murphy

Subscribed and sworn to before me, a Notary Public, this 6th day of May, 1955.

*J. M. Widenwood*  
 Notary Public

My commission expires March 15, 1958.