


Give All Information Completely
Make Required Affidavit
Mail or Deliver Report to:
Conservation Division
State Corporation Commission
211 No. Broadway
Wichita, Kansas

WELL PLUGGING RECORD

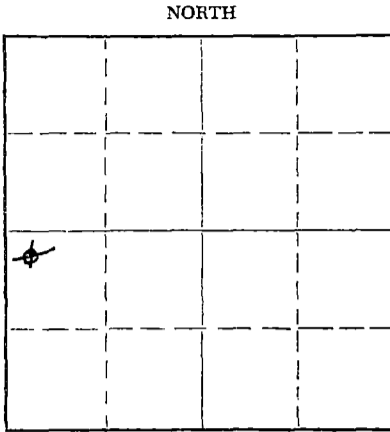

Locate well correctly on above Section Plat

County. Sec. 10 Twp. 27 Rge. 7 (E) (W) X
Location as "NE/CNW%SW%" or footage from lines NW NW SW/4
Lease Owner S. A. Murphy et al
Lease Name Beard Well No. 1
Office Address 712 Brown Bldg-Wichita 2, Kansas
Character of Well (completed as Oil, Gas or Dry Hole) dry hole
Date well completed June 11, 1957 19
Application for plugging filed " 19
Application for plugging approved " 19
Plugging commenced " 19
Plugging completed " 19
Reason for abandonment of well or producing formation _____

If a producing well is abandoned, date of last production _____ 19
Was permission obtained from the Conservation Division or its agents before plugging was commenced? yes

Name of Conservation Agent who supervised plugging of this well M. A. Rives
Producing formation _____ Depth to top _____ Bottom _____ Total Depth of Well 4155 Feet
Show depth and thickness of all water, oil and gas formations.

OIL, GAS OR WATER RECORDS

CASING RECORD

FORMATION	CONTENT	FROM	TO	SIZE	PUT IN	PULLED OUT
		0	226	8 5/8"	233	none

Describe in detail the manner in which the well was plugged, indicating where the mud fluid was placed and the method or methods used in introducing it into the hole. If cement or other plugs were used, state the character of same and depth placed, from _____ feet to _____ feet for each plug set.

Mudded to 225 ft. - set plug w/ 20 sx cement 1/4 sx hulls
Mudded to 35 ft. - set plug w/ 10 sx cement 1/4 sx hulls

(If additional description is necessary, use BACK of this sheet)

Name of Plugging Contractor Virginia Drilling Co Inc.
Address 712 Brown Bldg-Wichita 2, Kansas

STATE OF Kansas, COUNTY OF Sedgwick, ss.
S. A. Murphy (employee of owner) or (owner or operator) of the above-described well, being first duly sworn on oath, says: That I have knowledge of the facts, statements, and matters herein contained and the log of the above-described well as filed and that the same are true and correct. So help me God.

(Signature) [Signature]
712 Brown Bldg-Wichita 2, Kansas
(Address)

SUBSCRIBED AND SWORN TO before me this 14th day of June 19 57
[Signature]
Murlee Hawkins Notary Public.

My commission expires Febr. 5, 1961

PLUGGING
FIL SEC 10 T 27 R 7W
BOOK PAGE 20 LINE 13

JUN 13 1957
06-18-57
CORPORATION COMMISSION

Well: Beard #1
 Location: NW NW SW/4 Section 10-27s-7w, Kingman Co., Kansas
 Company: S. A. Murphy, et al
 Contractor: Virginia Drilling Co., Inc.
 Commenced: May 27, 1957
 Completed: June 12, 1957
 Total Depth: 4155
 Elevation: 1537 D.F.

FORMATION	DEPTH	
Surface clay	0-50	
Clay-sand	50-90	
Shale-shells	90-955	
Anhydrite	955-967	
Shale-lime	967-1075	Set 8-5/8" csg. @ 226'
Gyp-lime-shale	1075-1290	
Brk. lime-shale	1290-1475	
Brk. lime-sandy	1475-1580	
Lime-shale	1580-1865	
Brk. lime-shale	1865-1990	
Shale-lime	1990-2260	TOPS:
Lime-shale streaks	2260-2390	Douglas 2906
Brk. lime-shale	2390-2540	K. C. Lime 3120
Shale-lime	2540-2635	Marmaton 3584
Lime	2635-2640	Cherokee 3710
Lime-shale	2640-2785	Miss. Lime 3815
Shale	2785-2795	Kinderhook 3968
Chalky lime-shale	2795-2851	Viola 4118
Heebner	2851-2854	Simpson 4146
Shale	2854-2915	
Shale-lime-sand	2915-3020	
Douglas sand	3020-3102	
Lime	3102-3585	
Lime-shale	3585-3815	
Miss. Chert	3815-3848	
Lime-chert	3848-3890	
Lime-shale	3890-4065	
Shale	4065-4110	
Shale-lime	4110-4118	
Lime	4118-4132	
Lime-sand	4132-4155	

Now comes S. A. Murphy, who states that he is familiar with the drilling of oil and gas wells, and knows of his own knowledge that the Beard #1, located NW NW SW, Section 10-27s-7w, Kingman County, Kansas, was drilled to a total depth of 4155 feet. Same was plugged and abandoned.

S. A. Murphy
 S. A. Murphy

Subscribed and sworn to before me, a Notary Public, this 14th day of June, 1957.

Inez M. Underwood
 Inez M. Underwood
 Notary Public

RECEIVED
 STATE CORPORATION COMMISSION

My commission expires March 15, 1958.

JUN 20 1957

PLUGGING
 SEC 10 T 27 R 7W
 BOOK PAGE 20 LINE 13

COMMISSION DIVISION
