

15-095-01276-0900

WELL PLUGGING RECORD

Give All Information Completely
Make Required Affidavit
Mail or Deliver Report to:
Conservation Division
State Corporation Commission
800 Bitting Building
Wichita, Kansas

Kingman County, Sec. 10 Twp. 27S Rge. 7 (W)

Location as "NE/CNW/SW" or footage from lines 330 fr. West & 330 fr. N, NE/4

Lease Owner Phillips Petroleum Company

Lease Name McClure "B" Well No. 1

Office Address Box 779, Great Bend, Kansas

Character of Well (completed as Oil, Gas or Dry Hole) Dry Hole

Date well completed 9-9-55 19

Application for plugging filed 9-12-55 19

Application for plugging approved 9-13-55 19


Plugging commenced 9-22-55 19

Plugging completed 9-24-55 19

Reason for abandonment of well or producing formation Dry Hole

If a producing well is abandoned, date of last production 19

Was permission obtained from the Conservation Division or its agents before plugging was commenced? Yes

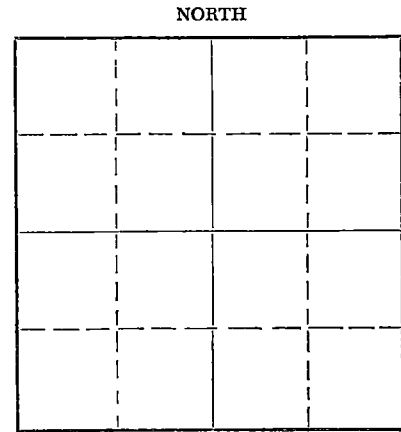

Locate well correctly on above Section Plat

Name of Conservation Agent who supervised plugging of this well Mr. M. A. Rives

Producing formation Viola Depth to top 4103 Bottom 4106 Total Depth of Well PB 3175 Feet

Show depth and thickness of all water, oil and gas formations.

OIL, GAS OR WATER RECORDS

CASING RECORD

FORMATION	CONTENT	FROM	TO	SIZE	PUT IN	PULLED OUT
Toronto	Dry	2891	2904	9-5/8"	213.66 OA	None
Brown Limestone	Dry	3103	3112	7"	4132.40 OA	2633.00 OA
LKC	Dry	3112	3568			
Marmaton	Dry	3573	3665			
Cherokee	Dry	3665	3804			
Mississippian	Dry	3804	3950			
Kinderhook	Dry	3950	4103			
Viola	Dry	4103	4106			

Describe in detail the manner in which the well was plugged, indicating where the mud fluid was placed and the method or methods used in introducing it into the hole. If cement or other plugs were used, state the character of same and depth placed, from feet to feet for each plug set.

Filled with sand from 3175' to 3110'. Dumped 5 sx. cement from 3110' to 3090'. Mudded hole from 3090' to 210'. Set 10' rock bridge to 200'. Dumped 20 sx. cement to 140'. Mudded to 35'. Set 5' rock bridge to 30'. Dumped 10 sx. cement in filling to base of cellar. Well plugged and abandoned at 10:00 A.M. 9-24-55.

(If additional description is necessary, use BACK of this sheet)

Name of Plugging Contractor West Supply Company
Address Chase, Kansas

STATE OF Kansas, COUNTY OF Barton, ss.
A. J. Willis (employee of owner)

well, being first duly sworn on oath, says: That I have knowledge of the facts, statements, and matters herein contained and the log of the above-described well as filed and that the same are true and correct. So help me God.

(Signature) *A. J. Willis*
Box 779, Great Bend, Kansas
(Address)

SUBSCRIBED AND SWORN TO before me this 26th day of September, 19 55

My commission expires November 18, 1957

Joseph M. Beal
Notary Public.

24-7368-S 3-53-20M

PLUGGING
FILE SEC 10 T 27 R 7W
BOOK PAGE 149 LINE 6

RECEIVED
CORPORATION COMMISSION
SEP 28 1955
CONSERVATION DIVISION
Wichita, Kansas

15-095-01276-0000

1 Dvile, Prod.
 1 Division
 1 District
 1 Geological Dept-Dvile
 1 Geological Dept-District

EXPLORATION RECORD

Phillips Petroleum Company - NE/4 Sec. 10-27S-7W, Kingman County, Kansas

Lease McDunn #33 Dry Hole - Plugged & Abandoned. Well 1

Formation Name	Top	Base	Remarks
Shale and Hedbed	0	387	
Shale and Shells	387	625	
Sandy Shale	625	930	
Shale	930	1075	
Lime	1075	1665	
Lime and Chert	1665	1760	
Shale and Lime	1760	2215	
Lime	2215	2420	
Lime and Shale	2420	2965	
Shale	2965	3103	
Br. Lime	3103	3112	
Lime	3112	3620	
Lime and Shale	3620	3801	
Misc. Chert	3801	3814	
Chert	3814	3850	Drillstem Test
Misc. Chert	3850	3950	
Lime and Shale	3950	4000	
Shale	4000	4106	
<u>FORMATION TOPS: (SAMPLES)</u>			
Number	2866		
Toronto	2891		
Douglas	2904		
Brown Limestone	3103		
Lansing-FC	3112		
Besse FC	3566		
Minerton	3573		
Charlotte	3665		
Mississippi	3801		
Kinderhook	3950		
Viola	4103		
Rotary TD	4106		
Cable Tool TD	FB 3175		

See Daily Report Detailed.
 depth penetrated at 4106'

RECEIVED
 STATE CORPORATION COMMISSION
 SEP 29 1955
 GEOSCIENCE DIVISION
 Wichita, Kansas

PLUGGING
 FILE SEC. 10 - T 27 R 7W
 BOOK PAGE 149 LINE 6

4103