

CONFIDENTIAL

COPY

TIGHT HOLE CONFIDENTIAL

STATE CORPORATION COMMISSION OF KANSAS
OIL & GAS CONSERVATION DIVISION
WELL COMPLETION FORM
ACO-1 WELL HISTORY
DESCRIPTION OF WELL AND LEASE

API NO. 15- 185-22,739-0000

County Stafford

SW NE SW Sec. 10 Twp. 24S Rge. 15W East

1650' Ft. North from Southeast Corner of Section

3630' Ft. West from Southeast Corner of Section
(NOTE: Locate well in section plat below.)

Lease Name IRMA SMITH Well # 2-10

Field Name Macksville East

Producing Formation Viola

Elevation: Ground 2019' KB 2028'

Total Depth 4190' PBTD None

Operator: License # 5056

Name: F. G. HOLL COMPANY

Address 6427 E. Kellogg

P.O. Box 780167

City/State/Zip Wichita, KS 67278-0167

Purchaser: Central States Gas Co.

Operator Contact Person: Elwyn H. Nagel

Phone (316) 684-8481

Contractor: Name: Sterling Drilling Company

License: 5142

Wellsite Geologist: W. Bryce Bidleman

Designate Type of Completion

New Well Re-Entry Workover

Oil SWD Temp. Abd.

Gas Inj Delayed Comp.

Dry Other (Core, Water Supply, etc.)

If ~~old~~ old well info as follows:

Operator: _____

Well Name: _____


Comp. Date _____ Old Total Depth _____

Drilling Method:

Mud Rotary Air Rotary Cable

11/16/90 11/24/90 12/11/90

Spud Date Date Reached TD Completion Date

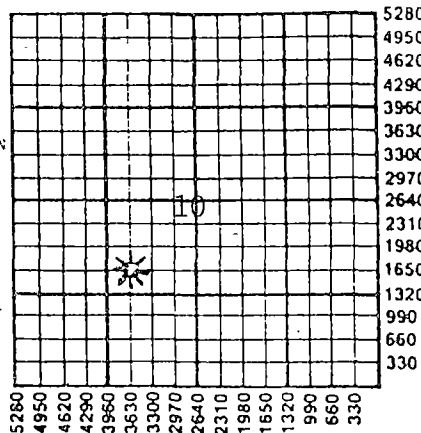

Amount of Surface Pipe Set and Cemented at 265' KB Feet

Multiple Stage Cementing Collar Used? Yes No

If yes, show depth set _____ Feet

If Alternate II completion, cement circulated from _____

feet depth to _____ w/ _____ sx cmt.

INSTRUCTIONS: This form shall be completed in triplicate and filed with the Kansas Corporation Commission, 200 Colorado Derby Building, Wichita, Kansas 67202, within 120 days of the spud date of any well. Rule 82-3-130, 82-3-107 and 82-3-106 apply. Information on side two of this form will be held confidential for a period of 12 months if requested in writing and submitted with the form. See rule 82-3-107 for confidentiality in excess of 12 months. One copy of all wireline logs and drillers time log shall be attached with this form. ALL CEMENTING TICKETS MUST BE ATTACHED. Submit CP-4 form with all plugged wells. Submit CP-111 form with all temporarily abandoned wells. Any recompletion, workover or conversion of a well requires filing of ACO-2 within 120 days from commencement date of such work.

All requirements of the statutes, rules and regulations promulgated to regulate the oil and gas industry have been fully complied with and the statements herein are complete and correct to the best of my knowledge.


Signature Elwyn H. Nagel

Title Elwyn H. Nagel, Manager Date 3/6/91

Subscribed and sworn to before me this 6th day of March, 1991.

Notary Public V. Jean Feil

Date Commission Expires _____

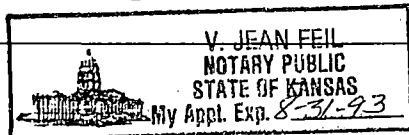

K.C.C. OFFICE USE ONLY

F Letter of Confidentiality Attached
C Wireline Log Received
C Drillers Time Log Received

Distribution

KCC SWD/Rep NGPA
 KGS Plug Other (Specify)