

15-095-00239-0000

STATE OF KANSAS
STATE CORPORATION COMMISSION

WELL PLUGGING RECORD

Give All Information Completely
Make Required Affidavit
Mail or Deliver Report to:
Conservation Division
State Corporation Commission
211 No. Broadway
Wichita, Kansas

Kingman County, Sec. 32 Twp. 27 Rge. 6 (E) W (W)

Location as "NE/CNW/SW" or footage from lines SE/4 SE/4 SE/4

Lease Owner W. J. Coppinger

Lease Name Robinson Well No. 1

Office Address 507 Union Nat'l. Bldg., Wichita, Kansas

Character of Well (completed as Oil, Gas or Dry Hole) Dry Hole

Date well completed 9/6 19 57

Application for plugging filed 9/6 19 57

Application for plugging approved 9/6 19 57


Plugging commenced 9/6 19 57

Plugging completed 9/6 19 57

Reason for abandonment of well or producing formation Dry Hole

If a producing well is abandoned, date of last production 19

Was permission obtained from the Conservation Division or its agents before plugging was commenced? Yes

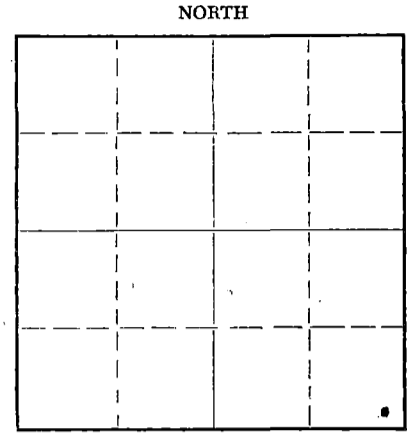

Locate well correctly on above Section Plat

Name of Conservation Agent who supervised plugging of this well M. A. Rives

Producing formation Depth to top Bottom Total Depth of Well 4405 Feet

Show depth and thickness of all water, oil and gas formations.

OIL, GAS OR WATER RECORDS

CASING RECORD

FORMATION	CONTENT	FROM	TO	SIZE	PUT IN	PULLED OUT
T. D. drilled to Arb.				8 5/8		

Describe in detail the manner in which the well was plugged, indicating where the mud fluid was placed and the method or methods used in introducing it into the hole. If cement or other plugs were used, state the character of same and depth placed, from _____ feet to _____ feet for each plug set.

Filled with heavy mud to 250'. Ran Halliburton plug 1/2 sack hulls, 20 sacks cement.

Filled with heavy mud to 35'. Ran Halliburton plug 1/2 sack hulls, 10 sacks cement.

(If additional description is necessary, use BACK of this sheet)

Name of Plugging Contractor D & M Drilling Company, Inc.

Address P. O. Box 247, Great Bend, Kansas

STATE OF Kansas, COUNTY OF Barton, ss.

W. M. Barnett (employee of owner) or (owner or operator) of the above-described well, being first duly sworn on oath, says: That I have knowledge of the facts, statements, and matters herein contained and the log of the above-described well as filed and that the same are true and correct. So help me God.

(Signature) W. M. Barnett

P. O. Box 247, Great Bend, Kansas

(Address)

SUBSCRIBED AND SWORN to before me this 9th day of September, 19 57

My commission expires July 29, 1961

Notary Public. [Signature]

PLUGGING
FILE SEC 32 T 27 R 6W
BOOK PAGE 43 LINE 32

15095-00239-0000

ROBINSON #1

SE/4 SE/4 SE/4 of Section 32-27S-6W, Kingman County, Kansas

Rigged up Rotary Tools 8/19/57

Ran 12 Jts. (256') 8-5/8" Casing
set @ 254'. Cemented w/175 sacks
common cement, 2% CC

Tore down Rotary Tools 9/6/57

<u>FORMATION</u>	<u>FROM</u>	<u>TO</u>
Blue Sand	0'	70'
Sand	70	95
Shale & shells	95	150
Red Rock & shale	150	256
Shale & shells	256	850
Salt, shale & shells	850	950
Shale & shells	950	960
Anhydrite	960	980
Shale & anhydrite streaks	980	1205
Shale & shells	1205	1410
Lime & shale	1410	1660
Shale	1660	2105
Shale & lime	2105	2885
Sandy shale	2885	3086
Lime & shale	3086	3267
Lime	3267	3589
Lime & shale	3589	3830
Lime & chert	3830	3890
Chert, lime & shale	3890	2967
Lime & shale	3967	4001
Cherty lime & shale	4001	4025
Lime & shale	4025	4065
Cherty lime & shale	4065	4105
Cherty lime	4105	4130
Cherty lime & shale	4130	4148
Lime & shale	4148	4224
Sandy lime & shale	4224	4255
Sandy lime	4255	4257
Lime, sand & shale	4257	4287
Sand & shale	4287	4320
Shale & lime	4320	4385
Lime	4385	4405 T. D.

I, W. M. Barnett, do hereby certify that the foregoing log is true and correct,
to the best of my knowledge and belief.

W. M. Barnett

Subscribed and sworn to before me this 10th day of September, 1957.

James Swanson
Notary Public

My Commission Expires: July 29, 1961

PLUGGING
FILE SEC. 32 T. 27 R. 6W
BOOK PAGE 43 LINE 32