

STATE OF KANSAS
STATE CORPORATION COMMISSION

WELL PLUGGING RECORD

Give All Information Completely
Make Required Affidavit
Mail or Deliver Report to:
Conservation Division
State Corporation Commission
211 No. Broadway
Wichita, Kansas

Kingman County. Sec. 32 Twp. 27S Rge. 6 (E) (W) X

Location as "NE/CNWSW3/4" or footage from lines SE SE SE

Lease Owner Capital Producers, Inc.

Lease Name Robinson Well No. 1

Office Address 6201 West Kellogg Wichita, Kansas 67209

Character of Well (completed as Oil, Gas or Dry Hole) Oil well

Date well completed January 15, 1964 19

Application for plugging filed May 4, 1964 19

Application for plugging approved May 5, 1964 19


Plugging commenced May 8, 1964 19

Plugging completed May 14, 1964 19

Reason for abandonment of well or producing formation Oil exhausted

If a producing well is abandoned, date of last production March 15, 1964 19

Was permission obtained from the Conservation Division or its agents before plugging was commenced? Yes

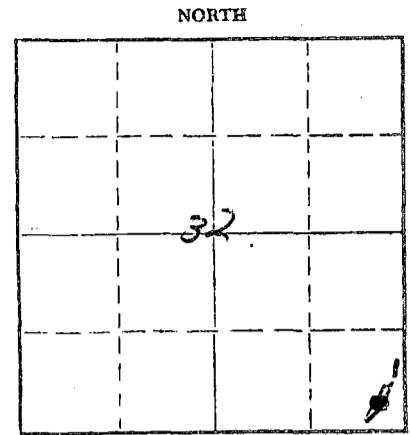

Locate well correctly on above Section Plat

Name of Conservation Agent who supervised plugging of this well A. Elving

Producing formation Viola Depth to top 4252 Bottom 4310 Total Depth of Well 4506 Feet

Show depth and thickness of all water, oil and gas formations.

OIL, GAS OR WATER RECORDS

CASING RECORD

FORMATION	CONTENT	FROM	TO	SIZE	PUT IN	PULLED OUT
				8 5/8		None
				5 1/2	4390	3674

Describe in detail the manner in which the well was plugged, indicating where the mud fluid was placed and the method or methods used in introducing it into the hole. If cement or other plugs were used, state the character of same and depth placed, from _____ feet to _____ feet for each plug set.

Checked hole, filled with sand from 4302' to 4240', dumped 5 sax of cement, cleaned celler, rigged up on 5 1/2" casing took out celler slip, worked pipe, had 23" tension worked to 25". Shot casing at 3767' worked to tension to 35", shot casing at 3674', worked loose and pulled 20 joints. Pulled 5 1/2" casing (95 joints), removed jacks from celler. Muded hole to 250' set 10' rock bridge and dumped 25 sax of cement, juded to 40' set 10' rock bridge and dumped 10 sax of cement to base of celler.

RECEIVED
STATE CORPORATION COMMISSION

JUL 1 1964

07-01-64
CONSERVATION DIVISION
Wichita, Kansas

(If additional description is necessary, use BACK of this sheet)

Name of Plugging Contractor Cherokee Drilling & Expl. Co., Inc.

Address 2500 East First, Pratt, Kansas

STATE OF _____, COUNTY OF _____, ss. _____ (employee of owner) or (owner or operator) of the above-described well, being first duly sworn on oath, says: That I have knowledge of the facts, statements, and matters herein contained and the log of the above-described well as filed and that the same are true and correct. So help me God.

(Signature) [Signature]

SUBSCRIBED AND SWORN to before me this 1st day of July, 1964
[Signature] (Address)

My commission expires 11-5-67

Notary Public.

