

JUN 06 1973

JUN 13 1973


15-095-20304-0000

STATE OF KANSAS  
STATE CORPORATION COMMISSION

Form CP-4

Give All Information Completely  
Make Required Affidavit  
Mail or Deliver Report to:  
Conservation Division  
State Corporation Commission  
P. O. Box 17027  
Wichita, Kansas 67217  
NORTH

WELL PLUGGING RECORD

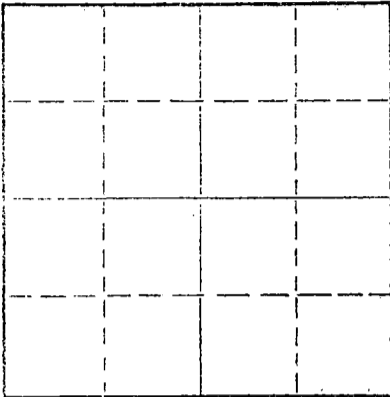

Locate well correctly on above  
Section Plat

Kingman County, Sec. 32 Twp. 27S Rge. 6W (E) (W)  
Location as "NE/CNW/SW" or footage from lines C SE/4 NW/4  
Lease Owner Vulcan Materials Co.  
Lease Name Stucky Well No. 1  
Office Address P.O. box 545, Wichita, Kansas  
Character of Well (completed as Oil, Gas or Dry Hole) Dry Hole  
Date well completed 5/24 19 73  
Application for plugging filed 5/24 19 73  
Application for plugging approved 5/24 19 73  
Plugging commenced 5/24 19 73  
Plugging completed 5/24 19 73  
Reason for abandonment of well or producing formation Dry Hole

If a producing well is abandoned, date of last production 19  
Was permission obtained from the Conservation Division or its agents before plugging was commenced? Yes

Name of Conservation Agent who supervised plugging of this well G.R. Biberstein  
Producing formation Depth to top Bottom Total Depth of Well 4,276' Feet  
Show depth and thickness of all water, oil and gas formations.

OIL, GAS OR WATER RECORDS

CASING RECORD

FORMATION	CONTENT	FROM	TO	SIZE	PUT IN	PULLED OUT
				13-3/8"	35.45'	0
				8-5/8"	224'	0

Describe in detail the manner in which the well was plugged, indicating where the mud fluid was placed and the method or methods used in introducing it into the hole. If cement or other plugs were used, state the character of same and depth placed, from feet to feet for each plug set.

Mud to 215'  
1/2 sx hulls  
plug cemented w/25 sx cement  
mud to 40'  
1/2 sx hulls  
Plug w/10 sx cement  
2' sx in rathole

RECEIVED  
STATE CORPORATION COMMISSION  
JUN 20 1973  
CONSERVATION DIVISION  
Wichita, Kansas

(If additional description is necessary, use BACK of this sheet)

Name of Plugging Contractor Red Tiger Drilling  
Address 1720 Wichita Plaza, Wichita, Kansas 67202


STATE OF Kansas COUNTY OF Sedgwick, ss.  
Linda Mowrey (employee of owner) or (owner or operator) of the above-described well, being first duly sworn on oath, says: That I have knowledge of the facts, statements, and matters herein contained and the log of the above-described well as filed and that the same are true and correct. So help me God.

(Signature) Linda Mowrey  
1720 Wichita Plaza, Wichita, Kansas  
(Address)

AND SWORN to before me this 5th day of June, 1973

Gloria Sawcett

Notary Public.

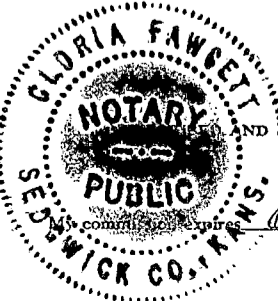

15-095-20304-0500

#1 Stucky  
DRILLERS LOG

CASING RECORD:

13-3/8" @ 35'  
w/160 sx cement  
8-5/8" @ 224'  
w/150 sx cement

COMPANY: Vulcan Materials Co.

CONTRACTOR: Red Tiger Drilling Co.

COMMENCED: 5/11/73

COMPLETED: 5/24/73

DESCRIPTION:

C SE/4 NW/4  
32-27S-6W  
Kingman County,  
Kansas

TOTAL DEPTH: 4276'

FORMATION	FROM	TO
Sand	0	20
Red Bed	20	280
Gray shale	280	310
Shale	310	935
Shale & Lime	935	2535
Lime	2535	2675
Lime & Shale	2675	2893
Shale	2893	2897
Shale & Sand	2897	3133
Base Lime	3133	3145
Lime	3145	3615
Lime & Shale	3615	3876
Mississippi	3876	3893
Lime & Chert	3893	3940
Mississippi	3940	3995
Mississippi Lime	3995	4045
Lime	4045	4095
Mississippi	4095	4155
Kinderhook	4155	4265
Shale & Chert	4265	4276

RECEIVED  
STATE CORPORATION COMMISSION  
JUN 20 1973  
CONSERVATION DIVISION  
Wichita, Kansas

I certify that this is a true and correct statement of the above log to the best of my knowledge.

Linda Nowrey  
Linda Nowrey

Subscribed and sworn to before me this 5th day of June, 1973.

Gloria Sawcett  
Notary Public

My Commission Expires: 10/25/76

