


STATE OF KANSAS
STATE CORPORATION COMMISSION

WELL PLUGGING RECORD

Give All Information Completely
Make Required Affidavit
Mail or Deliver Report to:
Conservation Division
State Corporation Commission
212 No. Market
Wichita, Kansas

Kingman County. Sec. 36 Twp. 27S Rge. (E) 6 (W)

Location as "NE/CNW/SW" or footage from lines C NE SW
Lease Owner Rosen Oil Company
Lease Name STOEHR Well No. 1
Office Address 605 Sutton Place, Wichita, Kansas 67202
Character of Well (completed as Oil, Gas or Dry Hole) DRY HOLE
Date well completed May 18, 19 68
Application for plugging filed 19
Application for plugging approved 19
Plugging commenced May 18, 19 68
Plugging completed May 18, 19 68
Reason for abandonment of well or producing formation Dry Hole

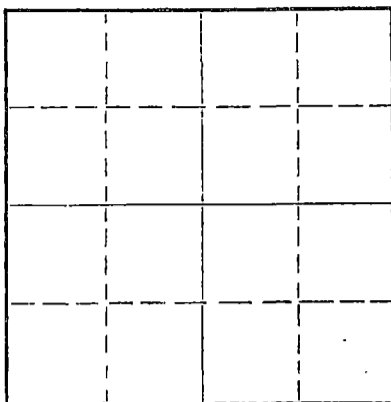

Locate well correctly on above Section Plat

If a producing well is abandoned, date of last production 19
Was permission obtained from the Conservation Division or its agents before plugging was commenced? Yes (Archie Elving)

Name of Conservation Agent who supervised plugging of this well _____
Producing formation _____ Depth to top _____ Bottom _____ Total Depth of Well 4185 Feet
Show depth and thickness of all water, oil and gas formations.

OIL, GAS OR WATER RECORDS

CASING RECORD

FORMATION	CONTENT	FROM	TO	SIZE	PUT IN	PULLED OUT
	Surface Casing	0	204'	8-5/8"	5/8/68	-----

Describe in detail the manner in which the well was plugged, indicating where the mud fluid was placed and the method or methods used in introducing it into the hole. If cement or other plugs were used, state the character of same and depth placed, from _____ feet to _____ feet for each plug set.

Heavy Mud from Total Depth to 200 Feet;
Hull Plug, Plug and 25 sax Cement thru
the Drill Pipe; Mud to 40 Feet; Hull Plug,
Plug and 8 sax Cement to Base of Cellar,
2 sax Cement in Rat Hole. Job Completed
at 8 A.M. on 5/18/68.

RECEIVED
STATE CORPORATION COMMISSION
MAY 21 1968
CONSERVATION DIVISION
Wichita, Kansas


(If additional description is necessary, use BACK of this sheet)

Name of Plugging Contractor Sage Drilling Co.
Address 500 Bitting Building, Wichita, Kansas 67202

STATE OF KANSAS COUNTY OF SEDGWICK, ss.
Wayne W. Kahmeyer of Sage Drilling Co. (employee of owner) or (owner or operator) of the above-described well, being first duly sworn on oath, says: That I have knowledge of the facts, statements, and matters herein contained and the log of the above-described well as filed and that the same are true and correct. So help me God.

(Signature) Wayne W. Kahmeyer
500 Bitting Building, Wichita, Kansas
(Address)

SUBSCRIBED AND SWORN to before me this 20th day of May 19 68
Louise K. Whitted
Louise K. Whitted - Notary Public.

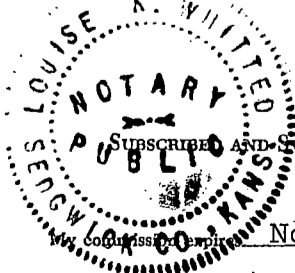

November 26, 1970.

15-095-20086-0000

DRILLERS LOG

STOEHR NO. 1

CASING RECORD:	OPERATOR:	Rosen Oil Company	DESCRIPTION:
8-5/8" @ 204'	CONTRACTOR:	Sage Drilling Co.	C NE SW
w/200 sax cement	COMMENCED:	May 8, 1968	Sec. 36-27S-6W
TOTAL DEPTH:	COMPLETED:	May 18, 1968	Kingman County, Kansas
4185'			ELEVATION: 1423KB

<u>FORMATION</u>	<u>FROM</u>	<u>TO</u>	<u>REMARKS</u>
Sand	0	35	
Shale	35	775	
Lime & Shale	775	1590	
Shale & Lime	1590	2020	
Lime & Shale	2020	3154	
Lime	3154	3251	
Lime & Shale w/Chert	3251	3335	
Lime & Shale	3335	3447	
Lime	3447	3518	
Shale & Lime	3518	3654	
Lime & Shale	3654	3764	
Chert	3764	3825	
Shale, Lime & Chert	3825	3888	
Lime & Chert	3888	3912	
Shale & Lime w/Chert	3912	4075	
Lime, Shale & Chert	4075	4142	
Lime, Shale & Simpson Sand	4142	4185	D&A

RECEIVED
 STATE CORPORATION COMMISSION
 MAY 21 1968
 CONSERVATION DIVISION
 Wichita, Kansas

I certify that this is a true and correct copy of the above log to the best of my knowledge.

SAGE DRILLING CO., INC.

By Wayne W. Kahmeyer
Wayne W. Kahmeyer



Subscribed and sworn to before me this 20th day of May, 1968.

Louise K. Whitted
 Louise K. Whitted, Notary Public

My commission expires:
November 26, 1970.