


15-159-19297-0000
WELL PLUGGING RECORD

Give All Information Completely
Make Required Affidavit
Mail or Deliver Report to:
Conservation Division
State Corporation Commission
212 No. Market
Wichita, Kansas

Rice County. Sec. 26 Twp. 21 Rge. 8 (E) 8 (W)
Location as "NE/CNW/SW" or footage from lines C SE/4 NW/4
Lease Owner Adair Oil Company
Lease Name Cossitt Well No. 1
Office Address 1005 East Second St., Wichita 14, Kansas
Character of Well (completed as Oil, Gas or Dry Hole) oil
Date well completed _____ 19____
Application for plugging filed June 21 19 67
Application for plugging approved _____ 19____
Plugging commenced July 5 19 67
Plugging completed July 7 19 67
Reason for abandonment of well or producing formation depleted

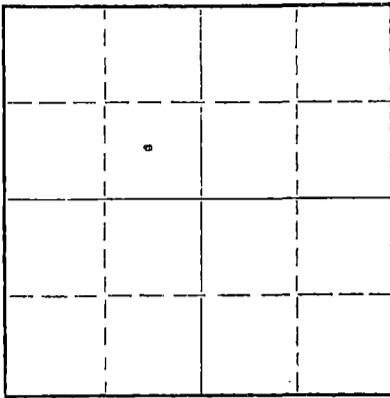

Locate well correctly on above
Section Plat

If a producing well is abandoned, date of last production _____ 19____
Was permission obtained from the Conservation Division or its agents before plugging was commenced? yes

Name of Conservation Agent who supervised plugging of this well Gilbert Toman
Producing formation _____ Depth to top _____ Bottom _____ Total Depth of Well 3363 Feet
Show depth and thickness of all water, oil and gas formations.

OIL, GAS OR WATER RECORDS

CASING RECORD

FORMATION	CONTENT	FROM	TO	SIZE	PUT IN	PULLED OUT
		0	270'	8 5/8"	270'	none
		0	3359'	4 1/2"	3359'	2803.80

Describe in detail the manner in which the well was plugged, indicating where the mud fluid was placed and the method or methods used in introducing it into the hole. If cement or other plugs were used, state the character of same and depth placed, from _____ feet to _____ feet for each plug set.

Pushed plug to 3325', set 10' rock bridge and dumped 5 sacks of cement.

Pushed plug to 260', set 10' rock bridge and dumped 20 sacks of cement.
Filled hole with mud to 40', set 10' rock bridge and capped hole with 10 sacks of cement.

RECEIVED
STATE CORPORATION COMMISSION

JUL 26 1967

07-26-67

CONSERVATION DIVISION
Wichita, Kansas

(If additional description is necessary, use BACK of this sheet)
Name of Plugging Contractor Pipe Pullers, Inc.
Address Box 486, Ellinwood, Kansas

STATE OF Kansas, COUNTY OF Barton, ss.
Dean Wells

(employee of owner) or (owner or operator) of the above-described well, being first duly sworn on oath, says: That I have knowledge of the facts, statements, and matters herein contained and the log of the above-described well as filed and that the same are true and correct. So help me God.

(Signature) Dean Wells

Ellinwood, Kansas

(Address)

SUBSCRIBED AND SWORN TO before me this 21st day of July, 19 67

J. J. Rader

My commission expires July 7, 1968

Notary Public.

E. H. Adair Oil Company
1005 East Second Street
Wichita 14, Kansas.

E. H. Adair Oil Company
No. 1 - Cossitt
C - SE/4 of NW/4 of
Sec. 26-Twp. 21 S.-Rge. 8 W.
Rice County, Kansas.

Elevation: 1,632 K.B.

Comm.: 4-27-63
Comp.: 5-5-63
Contractor:
E. H. Adair.
8-5/8 in. s/csg. @ 270 ft.
w/275 sax.
4-1/2 in. @ 3,359 ft.
w/100 sax.

Pro.

Figures indicate bottoms of formations:

Shale and lime to	2700	Shale	to	3194
Lime	2768	Lime		3222
Black shale	2773	Shale		3224
Lime	2778	Lime		3280
Shale	2787	Shale		3287
Lime	2795	Lime		3297
Shale	2918	Shale		3307
Lime	2928	Lime		3318
Shale	2951	Shale		3324
Lime	3061	Lime		3332
Porous lime	3072	Shale, gray, red		
Lime	3192	& green		3343
		Lime		3357
		Chert, shall show		
		of oil.		3363

TOPS:

HEEBNER	2768 (-1134)
DOUGLAS	2795 (-1163)
BROWN LIME	2918 (-1286)
LANSING-KANSAS CITY	2951 (-1319)
BASE KANSAS CITY	3280 (-1648)
BASAL PENN. CONGLOMER-	
ATE	3357 (-1725)

DST No. 1, 3345-63.

Open 45 minutes. Strong blow. Gas to surface in two minutes. Gauged 104,000 cu. ft. at ten minutes. Decreased rapidly to too small to measure. Sprayed oil in 40 minutes. Recovered 2,730 feet gas and gassy oil and 600 ft. saltwater. IBHP = 890 lbs. in 20 minutes; FBHP = 890 lbs. in 30 minutes; IFP = 636 lbs.; FFP = 845 lbs.

Certified correct:

K. W. Johnson
K. W. Johnson - Geologist.

RECEIVED
STATE CORPORATION COMMISSION

JUN 22 1967

CONSERVATION DIVISION
Wichita, Kansas