


WELL PLUGGING RECORD 15-155-02769-0000

Give All Information Completely  
Make Required Affidavit  
Mail or Deliver Report to:  
Conservation Division  
State Corporation Commission  
212 No. Market  
Wichita, Kansas

Reno County, Sec. 11 Twp. 23 Rge. ~~X(23)~~ 4 (W)

Location as "NE/CNW/SW" or footage from lines SE SE NE  
Lease Owner Sun Oil Company  
Lease Name Sabin "B" Well No. 6  
Office Address P. O. Box 729, Great Bend, Kansas 67530  
Character of Well (completed as Oil, Gas or Dry Hole) Oil  
Date well completed 1-11 19 35  
Application for plugging filed 11-4 19 70  
Application for plugging approved 11-5 19 70  
Plugging commenced 12-7 19 70  
Plugging completed 12-14 19 70  
Reason for abandonment of well or producing formation Depleted

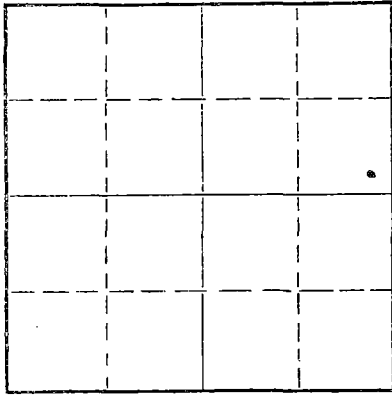

Locate well correctly on above Section Plat

If a producing well is abandoned, date of last production October 19 65  
Was permission obtained from the Conservation Division or its agents before plugging was commenced? Yes

Name of Conservation Agent who supervised plugging of this well Gilbert Toman  
Producing formation Mississippi Chat Depth to top 3346' Bottom 3370' Total Depth of Well 3623' Feet  
Show depth and thickness of all water, oil and gas formations.

OIL, GAS OR WATER RECORDS

CASING RECORD

FORMATION	CONTENT	FROM	TO	SIZE	PUT IN	PULLED OUT
				7"	3610'	2708.23'
				16"	164'	

Describe in detail the manner in which the well was plugged, indicating where the mud fluid was placed and the method or methods used in introducing it into the hole. If cement or other plugs were used, state the character of same and depth placed, from \_\_\_\_\_ feet to \_\_\_\_\_ feet for each plug set.

Made bottom hole plug back with sand to 3325', mixed and ran 6 sacks cement thru dump bailer.

Mudded hole to 215' - set 15' rock bridge. Filled hole with 6 yards ready-mix to base of cellar.

STATE RECEIVED  
CONSERVATION DIVISION  
Wichita, Kansas  
DEC 23 1970  
12-23-70

(If additional description is necessary, use BACK of this sheet)  
Name of Plugging Contractor Southwest Casing Pulling Company  
Address P. O. Box 364, Great Bend, Kansas 67530

STATE OF KANSAS, COUNTY OF BARTON, ss.

C. M. Graham (employee of owner) or (owner or operator) of the above-described well, being first duly sworn on oath, says: That I have knowledge of the facts, statements, and matters herein contained and the log of the above-described well as filed and that the same are true and correct. So help me God.

(Signature) C M Graham C. M. Graham  
P. O. Box 729, Great Bend, Kansas 67530  
(Address)

SUBSCRIBED AND SWORN TO before me this 21st day of December, 1970

My commission expires March 1, 1971  
Nash A. Gough Notary Public.

BARNSDALL OIL COMPANY,  
 BOX 2039,  
 TULSA, OKLAHOMA.

PR-4

15-155-02769-0000

Martha Sabin Well No. B-6

Loc: 330 ft. West of East line & 330 ft. North of  
 South line of NE/4 of Section 11-23S-4W,  
 Reno County, Kansas.

Drilling Commenced: 12-19-34  
 " Completed: 1-11-35  
 Drilled by: Arrow Drilling Co.

INITIAL PROD: Pot. 1693 bbls. (1-14-35) after acid 1000 gals. (1-12-35)

CASING RECORD:

15-1/2" 70#	8 thd.	Lapweld	8 jts.	156.40'	Set @ 164.40' w/ 125 sxs. cement
12-1/2" 50#	8 "	"	31 "	591.54'	" @ 599.54' w/ 250 " "
7" OD 22#	10 "	Nat. Tube	123 "	3603.67'	" @ 3609.97' w/ 185 " "

FORMATION RECORD

Sand & shale	0	166
Shale & gyp	166	460
Salt	460	514
Shale & shells	514	601
Shale & gyp	601	650
Shale & shells	650	1170
Shale	1170	1217
Shale & shells	1217	1316
Shale	1316	1650
Lime, broken	1650	1720
Shale	1720	1859
Lime	1859	1925
Shale	1925	1945
Shale & shells	1945	1991
Shale & lime	1991	2089
Lime, broken	2089	2237
Shale	2237	2495
Lime, K.C.	2495	2552
Shale	2552	2571
Lime	2571	2760
Shale, blue	2760	2790
Lime	2790	2805
Shale	2805	2820
Lime	2820	2933
Oolitic lime	2933	3006
Lime & shale	3006	3058
Lime	3058	3088
Lime & shale	3088	3128
Shale	3128	3277
Chat & shale	3277	3298
Chat	3298	3493
Chat & shale	3493	3522
Lime	3522	3525
Shale	3525	3558
Shale & shells	3558	3604
Hunton Lime (cored)	3604	3615 (Top of Hunton @ 3607' 6")
Lime	3615	3623
TOTAL DEPTH		3623

RECEIVED  
 STATE CORPORATION COMMISSION  
 NOV-5 1970  
 CONSERVATION DIVISION  
 Wichita, Kansas

3522  
 1492  
 2030

3346  
 35  
 3311

3290  
 3255  
 35

I, G. B. Hughes, being first duly sworn, on oath state that I have knowledge of the facts and matter herein set forth and that same are true and correct.

*G. B. Hughes*