


Give All Information Completely  
Make Required Affidavit  
Mail or Deliver Report to:  
Conservation Division  
State Corporation Commission  
212 No. Market  
Wichita, Kansas

WELL PLUGGING RECORD 15-155-02771-0000

Reno County, Sec. 11 Twp. 23 Rge. 4 (W)

Location as "NE/CNW/SW" or footage from lines SE NE NE  
Lease Owner Sun Oil Company  
Lease Name Sabin "B" Well No. 8  
Office Address P. O. Box 729, Great Bend, Kansas 67530  
Character of Well (completed as Oil, Gas or Dry Hole) Oil  
Date well completed 3-7 1935  
Application for plugging filed 11-4 1970  
Application for plugging approved 11-5 1970  
Plugging commenced 12-2 1970  
Plugging completed 12-7 1970  
Reason for abandonment of well or producing formation Depleted

NORTH

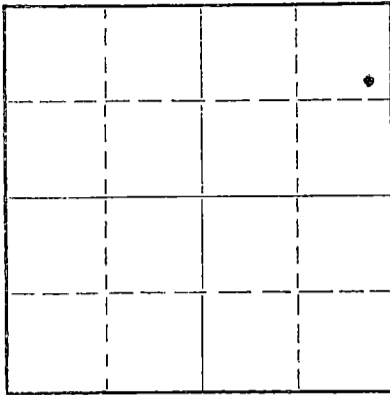

Locate well correctly on above Section Plat

If a producing well is abandoned, date of last production before January 1959  
Was permission obtained from the Conservation Division or its agents before plugging was commenced? Yes

Name of Conservation Agent who supervised plugging of this well Gilbert Toman  
Producing formation Hunton Depth to top 3607' Bottom 3609' Total Depth of Well 3609' Feet  
Show depth and thickness of all water, oil and gas formations.

OIL, GAS OR WATER RECORDS

CASING RECORD

FORMATION	CONTENT	FROM	TO	SIZE	PUT IN	PULLED OUT
				7"	3606'	2911.37'
				16"	130'	

Describe in detail the manner in which the well was plugged, indicating where the mud fluid was placed and the method or methods used in introducing it into the hole. If cement or other plugs were used, state the character of same and depth placed, from feet to feet for each plug set.

Made bottom hole plug back with sand to 3425', mixed and ran 6 sacks cement thru dump bailer.

Mudded hole to 225', set 15' rock bridge. Filled hole with 6 yards ready-mix to base of cellar.

RECEIVED  
STATE CORPORATION COMMISSION  
DEC 23 1970  
CONSERVATION DIVISION  
Wichita, Kansas  
12-23-70

(If additional description is necessary, use BACK of this sheet)

Name of Plugging Contractor Southwest Casing Pulling Co.  
Address P. O. Box 364, Great Bend, Kansas 67530

STATE OF KANSAS, COUNTY OF BARTON, ss.  
C. M. Graham (employee of owner) or (owner or operator) of the above-described well, being first duly sworn on oath, says: That I have knowledge of the facts, statements, and matters herein contained and the log of the above-described well as filed and that the same are true and correct. So help me God.

(Signature) C. M. Graham C. M. Graham  
P. O. Box 729, Great Bend, Kansas 67530  
(Address)

SUBSCRIBED AND SWORN TO before me this 21st day of December, 1970

My commission expires March 1, 1971

Nash A. Gough  
Nash A. Gough Notary Public.

Martha Sabin Well No. B-8,  
 Located 990' from North line & 330' from East line  
 of NE/4 of Sec. 11-23S-4W, Reno County, Kansas.

Drilling Comm: 2- 7-35  
 Drilling Comp: 3- 6-35  
 Drilled by: Mac & Stauffer

Initial Production: 1634 bbls/24 hrs. natural Potential (3-9-35) Pumping

Casing Record:

16"	65# & 70#	8 thd. LW	6 jts.	122.40'	Set @ 130' w/ 225 sxs. cement
15"	45#	8 " LW	31 "	604.43'	" @ 601.01' w/ 300 sxs. cement
7"	22#	10 " SS	123 "	3600.10'	" @ 3606' w/ 200 " "

Formation Record:


Surface soil	0	130
Shale	130	475
Shale & lime shells	475	500
Lime	500	760
Shale & lime	760	900
Lime	900	1020
Lime & shale	1020	1160
Shale	1160	1425
Shale & lime shells	1425	1555
Shale & lime	1555	1700
Broken lime	1700	1780
Shale & lime shells	1780	1830
Broken lime & shale	1830	1920
Shale & lime	1920	1985
Shale	1985	1995
Lime	1995	2307
Lime & shale	2307	2345
Shale	2345	2505
Sand & lime	2505	2545
Lime & shale	2545	2572
Lime	2572	2790
Broken lime	2790	2816
Lime & shale	2816	2912
Sandy lime	2912	2922
Hard shale & lime	2922	2936
Lime	2936	2980
Lime & shale	2980	3008
Shale	3008	3080
Shale & lime	3080	3154
Shale	3154	3258
Chat & lime	3258	3262
Chat	3262	3468
Lime	3468	3473
Lime & shale	3473	3514
Shale	3514	3568
Shale & lime	3568	3600
Shale	3600	3607' 2"
Hunton Lime	3607-2"	3609
TOTAL DEPTH		3609

15-155-02771-0000

325-6  
 1484  
 -----  
 1774

RECEIVED  
 STATE CORPORATION COMMISSION  
 NOV 5 1970  
 CONSERVATION DIVISION  
 Wichita, Kansas

I, G. B. Hughes, being first duly sworn, on oath state that I have knowledge of the facts and matter herein set forth and that same are true and correct.

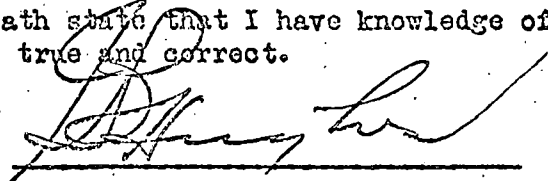

Subscribed and sworn to before me this 16th day of April, 1935