

WELL PLUGGING RECORD

15-155-02772-0000

Give All Information Completely  
Make Required Affidavit  
Mail or Deliver Report to  
Conservation Division  
State Corporation Commission  
318 No. Market  
Wichita, Kansas

Reno County, Sec. 11 Twp. 23 Rge. 4 (E) (W) X

NORTH


Locate well correctly on above Section Plat

Location as "NE/CNW/SW" or footage from lines \_\_\_\_\_  
 Lease Owner \_\_\_\_\_ Sun Oil Company  
 Lease Name \_\_\_\_\_ Sabin \_\_\_\_\_ Well No. B-9  
 Office Address \_\_\_\_\_ P. O. Box 729 Great Bend, Kansas  
 Character of Well (completed as Oil, Gas or Dry Hole) \_\_\_\_\_  
 Date well completed \_\_\_\_\_ 19\_\_\_\_  
 Application for plugging filed \_\_\_\_\_ 19\_\_\_\_  
 Application for plugging approved \_\_\_\_\_ 19\_\_\_\_  
 Plugging commenced \_\_\_\_\_ 1-6-71 \_\_\_\_\_ 19\_\_\_\_  
 Plugging completed \_\_\_\_\_ 1-18-71 \_\_\_\_\_ 19\_\_\_\_  
 Reason for abandonment of well or producing formation \_\_\_\_\_

If a producing well is abandoned, date of last production \_\_\_\_\_ 19\_\_\_\_  
 Was permission obtained from the Conservation Division or its agents before plugging was commenced? \_\_\_\_\_ Yes

Name of Conservation Agent who supervised plugging of this well \_\_\_\_\_ Gilbert Toman  
 Producing formation \_\_\_\_\_ Depth to top \_\_\_\_\_ Bottom \_\_\_\_\_ Total Depth of Well 3602 Feet  
 Show depth and thickness of all water, oil and gas formations.

OIL, GAS OR WATER RECORDS

CASING RECORD

FORMATION	CONTENT	FROM	TO	SIZE	PUT IN	PULLED OUT
				16	236	None
				8 5/8	3579	604' .19

RECEIVED  
STATE CORPORATION COMMISSION  
FEB 26 1971  
CONSERVATION DIVISION  
Wichita, Kansas  
15-155-02772-#1

Describe in detail the manner in which the well was plugged, indicating where the mud fluid was placed and the method or methods used in introducing it into the hole. If cement or other plugs were used, state the character of same and depth placed, from \_\_\_\_\_ feet to \_\_\_\_\_ feet for each plug set.

Pushed a plug down to 3500'; dumped 30 gallons of sand and 8 sacks of cement. Had 2" tension at 3500 psi and 3" at 4000 psi. Shot casing at 3010' and 2902'. Shot casing at 2812', 2705' and 2602'. Shot casing at 2204', 724' and 604'. Laid down 25 joints of 8 5/8" casing. Laid down 14 joints of 8 5/8" casing. Fluid at 75', couldn't bail fluid down. Pushed plug to 215'; dumped 10' rock bridge and 4 sacks of cement for overnight plug. Bailed out fluid to 215'.  
 Dumped 9 1/2 yards of ready mix concrete down 16" surface casing.

(If additional description is necessary, use BACK of this sheet)


Name of Plugging Contractor \_\_\_\_\_ Forbes Casing Pulling Company, Inc.  
 Address \_\_\_\_\_ P. O. Box 221 Great Bend, Kansas 67530

STATE OF \_\_\_\_\_ Kansas \_\_\_\_\_ COUNTY OF \_\_\_\_\_ Barton \_\_\_\_\_, ss.  
 \_\_\_\_\_ James W. Rockhold \_\_\_\_\_ (employee of owner) or (owner or operator) of the above-described

well, being first duly sworn on oath, says: That I have knowledge of the facts, statements, and matters herein contained and the log of the above-described well as filed and that the same are true and correct. So help me God.

(Signature) \_\_\_\_\_ James W. Rockhold \_\_\_\_\_  
 \_\_\_\_\_ P. O. Box 221 Great Bend, Kansas \_\_\_\_\_  
 \_\_\_\_\_ (Address)

Subscribed and Sworn to before me this 24 day of February 1971

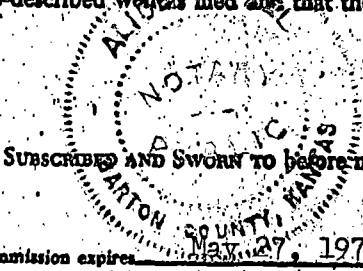

\_\_\_\_\_  
 Notary Public.


Give All Information Completely  
Make Required Affidavit  
Mail or Deliver Report to:  
Conservation Division  
State Corporation Commission  
212 No. Market  
Wichita, Kansas

WELL PLUGGING RECORD

Reno County, Sec. 11 Twp. 23 Rge. (E) 4 (W)

Location as "NE/CNW%SW%" or footage from lines NW SW NE  
Lease Owner Sun Oil Company  
Lease Name Sabin 'B' Well No. 9  
Office Address P. O. Box 729, Great Bend, Kansas, 67530  
Character of Well (completed as Oil, Gas or Dry Hole) Oil  
Date well completed April 19 1935  
Application for plugging filed December 28 1970  
Application for plugging approved December 30 1970  
Plugging commenced January 6 1971  
Plugging completed January 18 1971  
Reason for abandonment of well or producing formation Depleted

NORTH

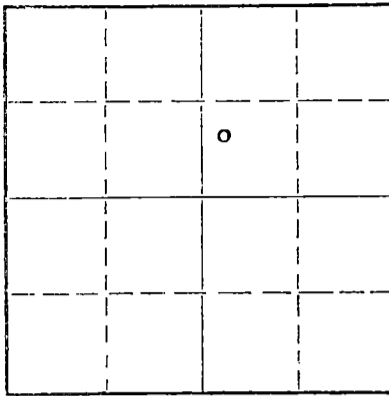

Locate well correctly on above Section Plat

If a producing well is abandoned, date of last production \_\_\_\_\_ 19\_\_\_\_  
Was permission obtained from the Conservation Division or its agents before plugging was commenced? Yes

Name of Conservation Agent who supervised plugging of this well Mr. Gilbert Toman  
Producing formation Hunton Depth to top 3579' Bottom 3602' Total Depth of Well 3602' Feet  
Show depth and thickness of all water, oil and gas formations.

OIL, GAS OR WATER RECORDS

CASING RECORD

FORMATION	CONTENT	FROM	TO	SIZE	PUT IN	PULLED OUT
				16"	236'	None
				8-5/8"	3579'	600'

Describe in detail the manner in which the well was plugged, indicating where the mud fluid was placed and the method or methods used in introducing it into the hole. If cement or other plugs were used, state the character of same and depth placed, from \_\_\_\_\_ feet to \_\_\_\_\_ feet for each plug set.

Filled with sand from 3602' to 3550' with 8 sx. cement on top of sand. Set rock bridge 215' to 200'. Dumped 5 sx. cement on top of rock bridge and filled 16" from 198' to surface with 6 yds. of ready-mix cement.

RECEIVED  
STATE CORPORATION COMMISSION  
MAR 5 1971  
CONSERVATION DIVISION  
Wichita, Kansas

(If additional description is necessary, use BACK of this sheet)

Name of Plugging Contractor Forbes Casing Pulling Company, Inc.  
Address P. O. Box 221, Great Bend, Kansas, 67530

STATE OF KANSAS, COUNTY OF BARTON, ss.  
R. V. Foulke (employee of owner) or ~~(producer or operator)~~ of the above-described well, being first duly sworn on oath, says: That I have knowledge of the facts, statements, and matters herein contained and the log of the above-described well as filed and that the same are true and correct. So help me God.

(Signature) R. V. Foulke  
Box 729, Great Bend, Kansas, 67530  
(Address)

SUBSCRIBED AND SWORN TO before me this 4th day of March, 19 71

Peggy L. Ollivan  
Peggy L. Ollivan  
Notary Public.

My commission expires January 12, 1974

Martha Sabin Well No. B-9  
 Log: 900' North & 350' East of SW corner of  
 NE/4 of Section 11-25S-4E, Reno County, Kansas.

Drilling Commenced: 3-22-35  
 Drilling Completed: 4-21-35  
 Drilled by: Kirk-Green-Way, Inc.

15-155-02772-0000

GASING RECORD

18" 55# 8 thd. Republic E.W. 12 jts. 240.44' Set @ 256.44 w/ 415 szs. cement  
 8-5/8" 20# & 32# 8 thd. J&L Smls. 128 " 3573.53' " @ 3579.0' w/ 125 " "

INITIAL PRODUCTION: 619 bbls/24 hrs.  
 Potential 1079 bbls/24 hrs. (4-26-35) after acidizing w/ 1000 gallons.

FORMATION RECORD:

Shale & sand	0	241	
Salt & shale	241	585	
Lime & shale	585	786	
Shale & lime shells	786	846	
Shale & shells	846	1095	
Sandy lime & shale, broken	1095	1150	
Shale	1150	1700	
Shale & shells	1700	1756	
Shale	1756	1944	
Lime, broken	1944	2064	
Lime	2064	2224	
Lime & shale	2224	2400	
Sandy shale	2400	2540	
Lime	2540	2615	
Lime, broken	2615	2705	
Sandy lime	2705	2760	
Lime	2760	2944	
Sandy lime	2944	2982	
Lime, shale & shells	2982	3006	
Shale & shells	3006	3295	
Chat	3295	3433	
Chat with shells	3433	3452	
Shale	3452	3481	
Shale & shells	3481	3568	
Shale	3568	3574	
Lime	3574	3577	
Lime	3577	3602	Total Depth
			Top of Hunton- 3560'

RECEIVED  
 STATE CORPORATION COMMISSION  
 DEC 30 1970  
 CONSERVATION DIVISION  
 Wichita, Kansas

I, G. B. Hughes, being first duly sworn, state that I have knowledge of the facts and matter herein set forth and that same are true and correct.

G. B. Hughes

Subscribed and sworn to before me this 10th day of May, 1935.

Harriet E. Baker  
 Notary, Public, Oklahoma

My commission expires: July 22 1935