


WELL PLUGGING RECORD

Give All Information Completely
Make Required Affidavit
Mail or Deliver Report to:
Conservation Division
State Corporation Commission
800 Bitting Building
Wichita, Kansas

Reno County. Sec. 11 Twp. 23 Rge. 1W (W)
Location as "NE/CNW $\frac{1}{4}$ SW $\frac{1}{4}$ " or footage from lines SE SW NE
Lease Owner Sunray Oil Corporation
Lease Name Sabin Well No. B-70
Office Address Box 195, Great Bend, Kansas
Character of Well (completed as Oil, Gas or Dry Hole) Oil
Date well completed 4-25 19 35
Application for plugging filed 6-1 19 51
Application for plugging approved 6-4 19 51
Plugging commenced 6-11 19 51
Plugging completed 6-16 19 51
Reason for abandonment of well or producing formation
Well Stopped Producing
If a producing well is abandoned, date of last production October 19 49
Was permission obtained from the Conservation Division or its agents before plugging was commenced? Yes

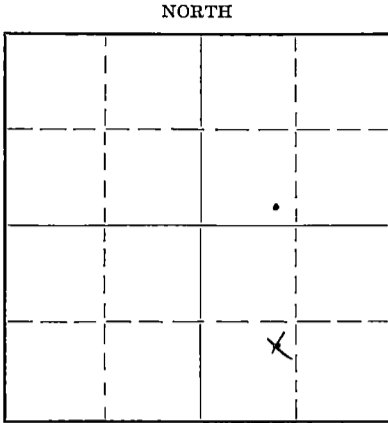

Locate well correctly on above Section Plat

Name of Conservation Agent who supervised plugging of this well R. Durkee
Producing formation Hunton Depth to top 3562' Bottom 3576' Total Depth of Well 3576' Feet
Show depth and thickness of all water, oil and gas formations.

OIL, GAS OR WATER RECORDS

CASING RECORD

Formation	Content	From	To	Size	Put In	Pulled Out
Shale & Lime		238'	465'	8-5/8"		3012'
Lime		500	1540			
Lime & shale		1830	3085			
Shale		3085	3254			
Shale		3494	3561			
Hunton Lime	Oil	3563	3576'			

Describe in detail the manner in which the well was plugged, indicating where the mud fluid was placed and the method or methods used in introducing it into the hole. If cement or other plugs were used, state the character of same and depth placed, from _____ feet to _____ feet for each plug set.

Rocked hole to 3560'. Run 8 sax of cement. Mudded hole to 245'. Set 10' rock bridge and run 30 sax of cement. Mudded hole to 10'. Run 8 sax on top. Well plugged.

RECEIVED
STATE CORPORATION COMMISSION
JUL - 7 1951
CONSERVATION DIVISION
Wichita, Kansas
7-7-51

(If additional description is necessary, use BACK of this sheet)

Correspondence regarding this well should be addressed to Sunray Oil Corporation
Address Box 195, Great Bend, Kansas

STATE OF KANSAS, COUNTY OF BARTON, ss.
W. E. Westbrook, Jr. (employee of owner) of the above-described well,
being first duly sworn on oath, says: That I have knowledge of the facts, statements, and matters herein contained and the log of the above-described well as filed and that the same are true and correct. So help me God.

(Signature) W. E. Westbrook, Jr.
Box 195, Great Bend, Kansas
(Address)

SUBSCRIBED AND SWORN TO before me this 2nd day of July, 1951

Maitha Scott
Notary Public.

My commission expires April 19, 1952.

PLUGGING
FILE SEC 11 T 23 R 4W
BOOK PAGE 85 LINE 37

Sunray Oil Corporation, #10 SABIN 'B'
 330' N & 990' E of SW Cor of NE/4
 Section 11-23S-4W
 Reno County, Kansas

15-155-02773-6000

DRILLING LOG:

Surface Sand	0	238
Shale & lime	238	420
Broken shale	420	465
Salt	465	480
Shale	480	500
Lime	500	1185
Brkn shale, lime & shells	1185	1280
Brkn lime & shale	1280	1415
Lime	1415	1540
Shale & Lime shells	1540	1640
Broken Lime & shale	1640	1695
Broken lime	1695	1830
Lime & shale	1830	1885
Broken lime	1885	2010
Lime	2010	2125
Shale & lime	2125	2190
Lime	2190	2300
Shale	2300	2500
Lime	2500	3005
Shale	3005	3060
Shale & lime	3060	3085
Shale	3085	3254
Chat	3254	3452
Broken lime	3452	3494
Shale	3494	3561
Gray shale	3561	3563½

TD DF 3576'

I, the undersigned, do hereby certify that ~~that~~ the above is a true and correct well log of the above described well to the best of my knowledge.

W. E. Westbrook, Jr.

Subscribed and sworn to before me this 6th day of July, 1951.

PLUGGING
 FILE SEC 11 T 23 R 40
 BOOK PAGE 85 LINE 37
 RECEIVED
 Notary Public

JUL - 7 1951

My Commission Expires ~~April 19, 1952.~~
 WICHITA, KANSAS