

STATE OF KANSAS
STATE CORPORATION COMMISSION
200 Colorado Derby Bldg.
Wichita, Kansas 67202


Form CP-4
Rev. 12-15-80

WELL PLUGGING RECORD

Give All Information Completely
Make Required Affidavit

COUNTY Ren SEC. 11 TWP 23 RGE. 3 W 1/4
Location as in quarters or footage from lines:

920 FT West + 1320 FT South of N/E Corner

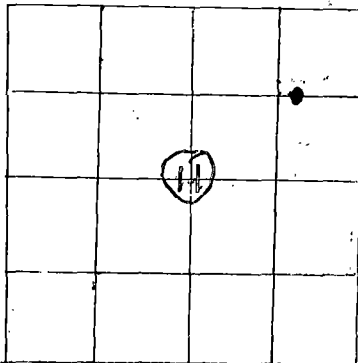

Locate Well
correctly on above
Section Platt.

Lease Owner SK Oil Co

Lease Name Sabin B Well No. 3

Office Address PO Box 559 Tulsa, OK 74101

Character of Well (Completed as Oil, Gas or Dry Hole): Oil

Date Well Completed 5-2-39

Application for plugging filed 8-6-85

Plugging commenced 8-6-85

Plugging completed 8-7-85

Reason for abandonment of well or producing formation 2" tubing

Spacker lost in hole & casing bad

Was permission obtained from the Conservation Division or it's

Agent's before plugging was commenced? Yes

Name of Conservation Agent who supervised plugging of this well Don Thompson

Producing formation 3261 Depth to top 3261 bottom T.D. 3874

Show depth and thickness of all water, oil and gas formations.

OIL, GAS OR WATER RECORDS Casing Record

Formation	Content	From	To	Size	Put in	Pulled Out
				1 1/2"	113.70	0
				1 1/2"	571.22	0
				8 3/4"	3253.19	

Describe in detail the manner in which the well was plugged, indicating where the mud fluid was placed and the method or methods used in introducing it into the hold. If cement or other plugs were used, state the character of same and depth placed, from _____ feet to _____ feet for each plug set.

Run 2 1/2" tubing to 2750'
Flowlog Pumped 10 sack perl + 50 sack cement
Pulled tubing to 370'
Pumped 50 sack cement w/ 4 sack hulls pumped 250 sack common
Circulated cement between 375' x 12 1/2'
Pulled up & pumped 75 sack filled casing & surface
to top w/ cement

(If additional description is necessary, use BACK of this sheet)

Name of Plugging Contractor _____

STATE OF Kansas COUNTY OF Ren, ss.
Ed Gressel (employee of owner) or (owner or operator) of the
above-described well, being first duly sworn on oath, says: That I have knowledge of the
facts, statements, and matters herein contained and the log of the above-described well as
filed and that the same are true and correct. So help me God.

(Signature) Ed Gressel
Box 336 Burdette
(Address)

SUBSCRIBED AND SWORN TO before me this 8th day of Aug, 19 85

Glenda Harber
Notary Public.

My Commission expires: 3-15-86



RECEIVED
STATE CORPORATION COMMISSION

AUG 9 1985
8-9-85
CONSERVATION DIVISION
Wichita, Kansas