


All Information Completely
Make Required Affidavit
Mail or Deliver Report to:
Conservation Division
State Corporation Commission
800 Bitting Building
Wichita, Kansas

OR
FORMATION PLUGGING RECORD

Strike out upper line
when reporting plug-
ging off formations.

NORTH

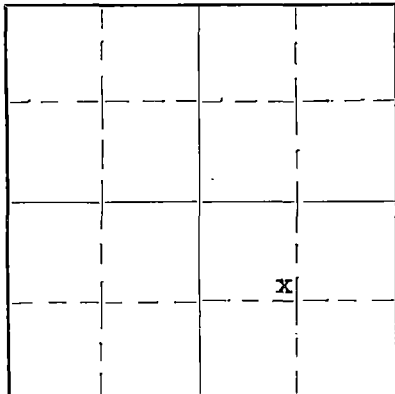

Locate well correctly on above
Section Plat

Reno County, Sec. 11 Twp. 23S Rge. (E) 4 (W)

Location as "NE 1/4 NW 1/4 SW 1/4" or footage from lines 990' S & 990' E of NW Cor of SE/4

Lease Owner Barnsdall Oil Co

Lease Name Martha Sabin Well No. C-9

Office Address Box 2039, Tulsa, Okla.

Character of Well (completed as Oil, Gas or Dry Hole) Oil

Date, well completed March 7th, 1935 193

Application for plugging filed March 1st, 1940 193

Application for plugging approved Feb. 28th, 1940 193

Plugging Commenced Feb. 22nd, 1940 193

Plugging Completed March 15th, 1940 193

Reason for abandoning of well or producing formation

Not producing in paying quantities

If a producing well is abandoned, date of last production Aug. 6th 1939 193

Was permission obtained from the Conservation Division or its agents before plugging was com-
menced? Yes - Verbal

Name of Conservation Agent who supervised plugging of this well Mr. Ruel Durkee, Lyons, Kansas

Producing formation Hunton Lime Depth to top 3572 Bottom 3595 Total Depth of Well 3595 Feet

Show depth and thickness of all water, oil and gas formations.



OIL, GAS OR WATER RECORDS

CASING RECORD

Formation	Content	From	To	Size	Put In	Pulled Out
Chat	Oil & Gas	3250	3460	24"	40'	None
Hunton Lime	Oil	3572	3595	16" OD	604.55'	None
				10 3/4"	2869.51'	2301' 11"
				7" OD	3567' 3"	3209' 1"

Describe in detail the manner in which the well was plugged, indicating where the mud fluid was placed and the method or methods used in introducing it into the hole. If cement or other plugs were used, state the character of same and depth placed, from _____ feet to _____ feet for each plug set.

Filled hole from 3595' to 3552' with Rotary. Cemented with 10 sacks. Top of cement 3500'. Filled with rotary mud from 3500' to 3209'. Cemented with 10 sacks. Top of cement plug 3157'. Filled with rotary mud from 3157' to 250'. Cemented with 15 sacks cement from 250' to 237'. Filled from 237' to surface with rotary mud and capped with 5 sacks cement.

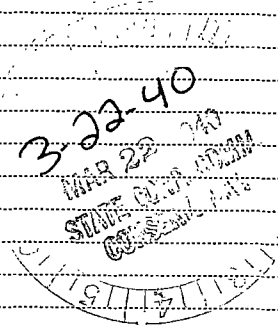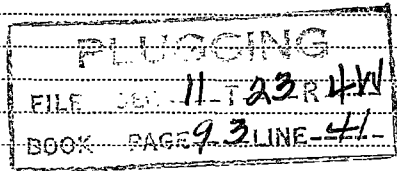

(If additional description is necessary, use BACK of this sheet)

Correspondence regarding this well should be addressed to The Barnsdall Oil Co

Address Box 2039, Tulsa, Okla.

STATE OF Kansas, COUNTY OF Reno, ss.

H. H. Echols (employee of owner) or (owner or operator) of the above-described well,

being first duly sworn on oath, says: That I have knowledge of the facts, statements, and matters herein contained and the log of the above-described well as filed and that the same are true and correct. So help me God.

(Signature) H. H. Echols

Box 396, Burrton, Kansas

(Address)

SUBSCRIBED AND SWORN to before me this 21st day of March 1940, 19

My commission expires March 16th, 1941

J. F. Franklin Notary Public

BARNSDALL OIL COMPANY
 MARTHA SABIN WELL NO. C-9

15-155-02786-0000

Located: 990' South & 990' East of NW corner Drilling Comm: 1-25-35
 of SE/4 of Section 11-23S-4W, Reno County, Kans Drilling Comp: 3-7-35

INITIAL PRODUCTION: Pumped 1356 Bbls in 24 hrs. Potental (3-12-35)

CASING RECORD:

Set 40' of 24" Surface pipe, cemented with 50 Sacks., recemented with 25 Sacks
 Set 604.55' of 16" OD Casing, cemented with 200 Sacks
 Set 2869.51' of 10 3/4" Casing, Cemented with 150 Sacks
 Set 3567' 3" of 7" OD 22# Casing, cemented with 175 Sacks

FORMATION RECORD:

Sand	0	42
Sand, Clay, Gyp & Shells	42	200
Shale & Shells	200	550
Lime & Shale	550	1060
Shale & Lime Shells	1060	1400
Shale & Shells	1400	1570
Lime & Shale	1570	1837
Shale & Shells	1837	1945
Lime, broken	1945	2042
Shale & Shells	2042	2138
Lime	2138	2282
Lime & Shale	2282	2360
Shale	2360	2529
Lime & Shale	2529	2616
K. C. Lime	2616	2722
Shale & Lime	2722	2755
Lime & Shale	2755	2811
Lime, hard	2811	2880
Shale & Lime	2880	2885
Lime	2885	2924
Sand - Water	2924	2934
Lime	2934	2954
Shale	2954	2960
Lime	2960	3070
Shale & Lime shells	3070	3104
Lime	3104	3110
Shale	3110	3170
Shale & Shells	3170	3216
Shale	3216	3250
Chat	3250	3460
Shale	3460	3573
Hunt on Lime	3573	3595

Total Depth

