


STATE OF KANSAS
STATE CORPORATION COMMISSION

WELL PLUGGING RECORD

Give All Information Completely
Make Required Affidavit
Mail or Deliver Report to:
Conservation Division
State Corporation Commission
800 Bitting Building
Wichita, Kansas

Stafford County. Sec. 3, Twp. 24, Rge. 11 (W)
Location as "NE/CNW $\frac{1}{4}$ SW $\frac{1}{4}$ " or footage from lines C E/2 SE/1 NW/1
Lease Owner Great Lakes Carbon Corporation
Lease Name Buckles Well No. 1
Office Address 501 Petroleum Bldg., Wichita, Kansas
Character of Well (completed as Oil, Gas or Dry Hole) Oil
Date well completed Jan. 12, 1943
Application for plugging filed Sept. 30, 1949
Application for plugging approved Oct. 1, 1949
Plugging commenced Oct. 13, 1949
Plugging completed Oct. 19, 1949
Reason for abandonment of well or producing formation Exhausted

NORTH

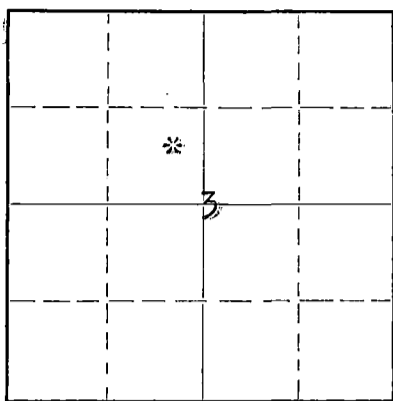

Locate well correctly on above
Section Plat

If a producing well is abandoned, date of last production Aug. 27, 1949
Was permission obtained from the Conservation Division or its agents before plugging was commenced? Yes

Name of Conservation Agent who supervised plugging of this well C. D. Stough
Producing formation Viola Depth to top 3701 Bottom 3730 Total Depth of Well 3730 Feet
Show depth and thickness of all water, oil and gas formations.

OIL, GAS OR WATER RECORDS

CASING RECORD

Formation	Content	From	To	Size	Put In	Pulled Out
				8-5/8"	324	0
				5-1/2"	3700	2677

Describe in detail the manner in which the well was plugged, indicating where the mud fluid was placed and the method or methods used in introducing it into the hole. If cement or other plugs were used, state the character of same and depth placed, from _____ feet to _____ feet for each plug set.

Crushed rock 3730-3700
Cement 3700-3670 5 sacks
Mud 3670-300
Cement 300-240 15 sacks
Mud 240-30
Cement 30 to cellar 10 sacks

RECORDED
OCT 26 1949
10-26-49

(If additional description is necessary, use BACK of this sheet)

Correspondence regarding this well should be addressed to Great Lakes Carbon Corporation.
Address 501 Petroleum Bldg., Wichita 2, Kansas

STATE OF KANSAS, COUNTY OF SEDGWICK, ss.
I, D. H. Sholtus, Prod. Supt. (employee of owner) or (owner or operator) of the above-described well, being first duly sworn on oath, says: That I have knowledge of the facts, statements, and matters herein contained and the log of the above-described well as filed and that the same are true and correct. So help me God.

(Signature) *D. H. Sholtus*
501 Petroleum Bldg., Wichita, Kansas
(Address)

SUBSCRIBED AND SWORN to before me this 25th day of October, 1949

My commission expires January 22, 1951

Jack F. Sheakster
Notary Public.

PLUGGING
BOOK PAGE 117 LINE 4

GREAT LAKES CARBON CORPORATION
 NO. 1 Buckles

Sec. 3, Twp. 24S, Rge. 11W
 Cen E $\frac{1}{2}$ SE NW

Total Depth: 3730'

Production: flowing 40
 barrels per hour

Comm. Date: December 14, 1942

Comp. Date: January 12, 1943

Contractor: Crow Drilling Company

Casing Record:


8 5/8" 324
 5 1/2" 3700

Geological Data

surface clay	30
sand	190
red rock	295
shale and shell	532
Anhydrite	570
shale & shell	1109
salt	1405
shale	1414
Anhydrite	1426
shale & shells	1465
Anhydrite & shale	1515
shale & lime	1627
shale	1641
cherty lime	1670
broken lime & shale	1742
lime & shale	1810
broken shale	1845
lime & chert	1867
lime & shale	2032
lime	2052
lime & shale	2083
lime & chert	2094
lime & shale	2122
shale & shells	2209
shale & lime	2695
shale & shells	2789
shale & lime	2900
broken lime	2970
lime	3041
broken lime	3121
lime	3171
broken lime	3380
lime	3384
lime & cherty	3475
lime	3670
lime & cherty	3700
Viola Dolomite	3730

Top Viola 3695

T.D.

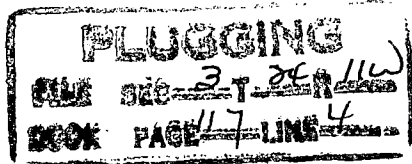

RECEIVED

STATE CORP. DIV.

OCT 1 X 1949

STATE CORPORATION
 COMMISSION
 KANSAS

GREAT LAKES CARBON CORPORATION
 NO. 1 Buckles

Sec. 3, Twp. 24S, Rge. 11W
 Gen E $\frac{1}{2}$ SE NW

Total Depth: 3730'

Production: flowing 40
 barrels per hour

Comm. Date: December 11, 1942
 Comp. Date: January 12, 1943

Contractor: Crow Drilling Company

Casing Record:
 8 5/8" 324
 5 1/2" 3700

Geological Data

Top Viola 3695

surface clay	30
sand	190
red rock	295
shale and shell	532
Anhydrite	570
shale & shell	1109
salt	1405
shale	1414
Anhydrite	1426
shale & shells	1465
Anhydrite & shale	1515
shale & lime	1627
shale	1641
cherty lime	1670
broken lime & shale	1742
lime & shale	1810
broken shale	1845
lime & chert	1867
lime & shale	2032
lime	2052
lime & shale	2083
lime & chert	2094
lime & shale	2122
shale & shells	2209
shale & lime	2695
shale & shells	2789
shale & lime	2900
broken lime	2970
lime	3041
broken lime	3121
lime	3171
broken lime	3380
lime	3384
lime & cherty	3475
lime	3670
lime & cherty	3700
Viola Dolomite	3730

T.D.

RECEIVED

Commissioner of Geology

OCT 26 1949

STATE CORPORATION
 COMMISSION
 KANSAS

PLUGGING

FILE SEC-3 T 24 R 4
 BOOK PAGE 17 LINE 4