


STATE OF KANSAS
STATE CORPORATION COMMISSION

Give All Information Completely
Make Required Affidavit
Mail or Deliver Report to:
Conservation Division
State Corporation Commission
800 Bitting Building
Wichita, Kansas

WELL PLUGGING RECORD

NORTH

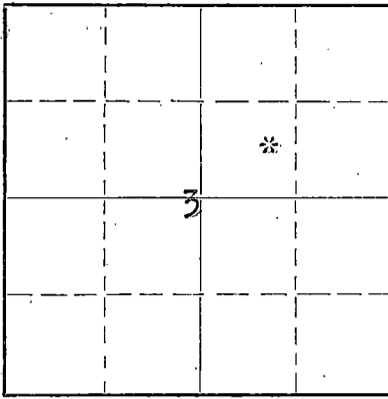

Locate well correctly on above
Section Plat

Stafford County, Sec. 3 Twp. 24 Rge. 11 (E) (W)
Location as "NE/CNW $\frac{1}{4}$ SW $\frac{1}{4}$ " or footage from lines C E/2 SW/4 NE/4
Lease Owner Great Lakes Carbon Corporation
Lease Name Johnson Well No. 1
Office Address 501 Petroleum Bldg., Wichita, Kansas
Character of Well (completed as Oil, Gas or Dry Hole) Oil
Date well completed Mar. 11, 1943
Application for plugging filed Sept. 30, 1949
Application for plugging approved Oct. 1, 1949
Plugging commenced Oct. 3, 1949
Plugging completed Oct. 12, 1949
Reason for abandonment of well or producing formation Exhausted

If a producing well is abandoned, date of last production Aug. 29, 1949
Was permission obtained from the Conservation Division or its agents before plugging was commenced? Yes

Name of Conservation Agent who supervised plugging of this well G. D. Stough
Producing formation Viola Depth to top 3691 Bottom 3735 Total Depth of Well 3735 Feet
Show depth and thickness of all water, oil and gas formations.

OIL, GAS OR WATER RECORDS

CASING RECORD

Formation	Content	From	To	Size	Put In	Pulled Out
				8-5/8	213	0
				5-1/2	3723	2215

Describe in detail the manner in which the well was plugged, indicating where the mud fluid was placed and the method or methods used in introducing it into the hole. If cement or other plugs were used, state the character of same and depth placed, from _____ feet to _____ feet for each plug set.

Crushed rock 3735-3690
Cement 3690-3660 5 sacks
Mud 3660-240
Cement 240-200 15 sacks
Mud 200-30
Cement 30 to cellar 10 sacks

RECEIVED

OCT 26 1949

STATE CORPORATION
COMMISSION
KANSAS

10-26-49

(If additional description is necessary, use BACK of this sheet)

Correspondence regarding this well should be addressed to Great Lakes Carbon Corporation
Address 501 Petroleum Bldg., Wichita 2, Kansas

STATE OF KANSAS, COUNTY OF SEDGWICK, ss.
I, D. H. Sholtus, Prod. Supt. (employee of owner) or (owner/operator) of the above-described well, being first duly sworn on oath, says: That I have knowledge of the facts, statements, and matters herein contained and the log of the above-described well as filed and that the same are true and correct. So help me God.

(Signature) *D. H. Sholtus*

501 Petroleum Bldg., Wichita, Kansas (Address)

SUBSCRIBED AND SWORN to before me this 25th day of October, 1949

Jack F. Phelan
Notary Public.

My commission expires January 22, 1951

PLUGGING
FILE SEC 3 T 24 R 11W
BOOK PAGE 117 LINE 5

DRILLER'S LOG

Great Lakes Carbon Corporation

JOHNSON# 1
 CE/2 SW/4 NE/4
 3-24-11W.
 Stafford County, Kansas

Total Depth 3735'
 Comm. 1/13/43
 Comp. 2/13/43

Casing Record:

8-5/8" Surface casing
 at 243' 8 Jts with
 125 sacks cement
 5-1/2" casing at 3693'
 119 Jts with 100 sacks
 cement.

Clay	28
Sand	180
Red Fork	250
Red Shale	527
Anhydrite	563
Shale & Shells	1100
Salt	1235
Broken Lime	1361
Shale	1418
Anhydrite	1443
Lime	1483
Broken Lime	1639
Lime	1663
Cherty Lime	1672
Lime	1704
Lime & Shale	1789
Broken Lime	1835
Sandy Lime, Cherty	1861
Lime	1879
Lime & Shale	1944
Lime	1987
Shale	2046
Lime	2059
Lime & Shale	2088
Cherty Lime	2094
Lime	2104
Lime & Shale	2547
Broken Lime	2601
Lime	2637
Shale	2654
Lime & Shale	2727
Shale	2805
Shale & Lime	2880
Lime	2931
Broken Lime	3006
Lime	3179
Broken Lime & Shale	3257
Lime & Shale	3327
Lime	3383
Lime, Cherty	3468
Lime	3518
Soft Lime	3524
Lime	3644
Lime, Cherty	3675
Shale	3691
Chert	3693
Cherty Lime	3696
Cong.	3701
Viola Lime	3735

STATE OF KANSAS)
)
 COUNTY OF SEDGWICK: ss

I, the undersigned, bring duly sworn,
 on oath, state that this statement and
 log is a true and correct record and
 log of the well drilled at the location
 above described.

GREAT LAKES CARBON CORP.

D. H. Sholtus Prod. Supt.
 D. H. Sholtus. Prod. Supt.

Subscribed and sworn to before me
 this 25th day of October 1949.

Jack F. Shearston
 Notary Public.

My commission expires:
 Jan. 22, 1951.

RECEIVED

Conservation Div.

OCT 26 1949

STATE CORPORATION
 COMMISSION
 KANSAS

PLUGGING
 FILE SEC 2 T 24 R 11 W
 BOOK PAGE 117 LINE 5

TD