

STATE OF KANSAS
STATE CORPORATION COMMISSION

WELL PLUGGING RECORD

Give All Information Completely
Make Required Affidavit
Mail or Deliver Report to:
Conservation Division
State Corporation Commission
800 Biting Building
Wichita, Kansas

OR

FORMATION PLUGGING RECORD

Strike out upper line
when reporting plug-
ging off formations.

Stafford County. Sec. 1 Twp 24 Rge. 10 (W)

Location as "NE1/4NW1/4SW1/4" or footage from lines NW NW NW NW SW

Lease Owner Sunray Oil Corporation

Lease Name McNickle Well No. 1

Office Address Box 195, Great Bend, Kansas

Character of Well (completed as Oil, Gas or Dry Hole) Oil

Date well completed 3-20 1941

Application for plugging filed 2-13 1948

Application for plugging approved 2-14 1948


Plugging commenced 1-17 1948

Plugging completed 1-31 1948

Reason for abandonment of well or producing formation Depleted

If a producing well is abandoned, date of last production 10-10 1947

Was permission obtained from the Conservation Division or its agents before plugging was com-
menced? No

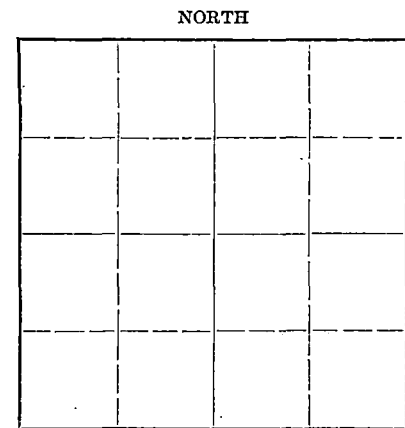

Locate well correctly on above
Section Plat

Name of Conservation Agent who supervised plugging of this well H. W. Kerr (J. O. Forbes)

Producing formation Viola Depth to top 3709 Bottom 3745 Total Depth of Well 3745 Feet

Show depth and thickness of all water, oil and gas formations.

OIL, GAS OR WATER RECORDS

CASING RECORD


Formation	Content	From	To	Size	Put In	Pulled Out
Viola	Oil	3709	3745	13-3/8"	148'	None
				10-3/4"	273	None
				5-1/2"	3713	1814'

Describe in detail the manner in which the well was plugged, indicating where the mud fluid was placed and the method or methods used in introducing it into the hold. If cement or other plugs were used, state the character of same and depth placed, from.....feet to.....feet for each plug set.

Filled w/ crushed rock to 3700' and dumped 5 sx cement on top of rock w/dump bailer. Mudded hole to 27', bridged and dumped 15 sx cement. Mudded hole to surface and capped w/ 10 sx cement.

(If additional description is necessary, use BACK of this sheet)

Correspondence regarding this well should be addressed to Sunray Oil Corporation
Address Box 195, Great Bend, Kansas

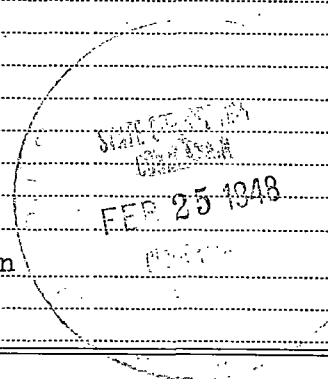

STATE OF KANSAS, COUNTY OF BARTON, ss.


Fred McDaniel (employee of owner) of the above-described well,
being first duly sworn on oath, says: That I have knowledge of the facts, statements, and matters herein contained and the log of the above-described well as filed and that the same are true and correct. So help me God.

(Signature) Fred McDaniel Div. Engr.
Box 195, Great Bend, Kansas
(Address)

SUBSCRIBED AND SWORN TO before me this 23 day of February 1948

My commission expires June 10, 1950

Notary Public.

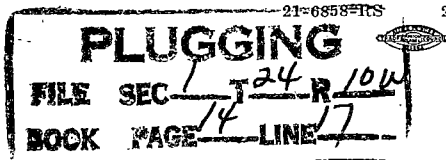

Sunray Oil Corporation

MCNICKLE #1

NW-SW/4

Sec 1-24-11

Stafford, County, Kansas

Well Log:

<u>Formation</u>	<u>Depth</u>	<u>Formation</u>	<u>Depth</u>
Shale shells & sand	148	Lime	2965
Sand & Red bed	204	Lime	3018
Sand & red bed	220	Lime	3042
Sand & red bed	285	Lime broken	3105
Red bed & shale	504	Lime	3146
Anhydrite	520	Lime & shale	3196
Red bed & shale	570	Lime & shale broken	3243
Shale & shells	1090	Shale	3265
Salt shale & shells	1255	Sand & shale	3287
Shale & shells	1340	Shale & shells & red bed	3311
Lime broken	1480	Broken lime & shale	3342
Broken lime & shale	1590	Broken lime & shale	3347
Broken Lime & shale	1664	Chert	3350
lime & shale breaks	1824	Broken Lime	3374
Lime & shale	1848	Broken lime	3397
Cherty lime & shale	1852	Lime & shale Breaks	3461
Broken Lime & shale	1925	Shale & shells	3487
Shale	1940	Cherty lime & shale	3494
Broken lime	2015	Sticky lime	3520
Lime broken	2110	Broken lime	3530
Shale & shells	2165	Lime	3553
Lime & shale	2306	Lime & shale	3561
Shale & shells	2396	Lime	3604
Lime broken	2430	Lime Red Rock & shale	3631
Shale & shells & red bed	2500	Lime & chert	3669
Shale & shells	2517	Shale	3687
Lime	2534	Top of Sand 3687-97'	
Red bed & shale	2570	Hard Sand	3696
Lime	2580	Shale & red rock	3710
Shale	2604	Top of Viola Lime 3709'	
Lime	2641	Broken Lime	3717
Lime & shale	2670	Lime & shale	3729
Shale & shells	2729	Chert	3745
Lime	2756		
Broken Lime	2770	Ran 144'-13-3/8"OD @ 148' w/75 sax cmt.	
Lime & some chat	2780	Ran 273'-10 3/4" @ 285' w/106 sax cmt.	
Shale & shells	2833	Ran 5 1/2"OD 14# 8 Rd Thd at 3713',	
Lime & shale broken	2857	Cemented w/150 sax cement.	
Soft lime	2866		
Shale & lime	2909		
Lime	2913		

I, Fred McDaniel, do hereby certify that the above is a true and complete log of Sunray Oil Corporation's McNickle #1 located NW-SW/4 Sec 1-24-11, Stafford County, Kansas.

Fred McDaniel Div. Engr.

Subscribed and sworn to before me this 23rd day of February 1948.

My Commission Expires: June 16, 1950;

Viola Beck
Notary Public

PLUGGING
FILE SEC 1-T-24-R-10W
BOOK PAGE 14 LINE 17

FEB 25 1948