


STATE OF KANSAS  
STATE CORPORATION COMMISSION

WELL PLUGGING RECORD

Give All Information Completely  
Make Required Affidavit  
Mail or Deliver Report to:  
Conservation Division  
State Corporation Commission  
800 Bitting Building  
Wichita, Kansas

Stafford County. Sec. 1 Twp. 24 Rge. (E) 11(W)  
Location as "NE/CNW $\frac{1}{4}$ SW $\frac{1}{4}$ " or footage from lines C E/2 SE/4  
Lease Owner The Derby Oil Company  
Lease Name McNickle Well No. 1  
Office Address 422 W. Douglas, Box 1030, Wichita, Kansas  
Character of Well (completed as Oil, Gas or Dry Hole) Oil Well  
Date well completed July 25 19 42  
Application for plugging filed May 2 19 52  
Application for plugging approved May 7 19 52  
Plugging commenced July 1 19 52  
Plugging completed July 9 19 52  
Reason for abandonment of well or producing formation Well has reached its economic limit.  
If a producing well is abandoned, date of last production March 19 52  
Was permission obtained from the Conservation Division or its agents before plugging was commenced? Yes

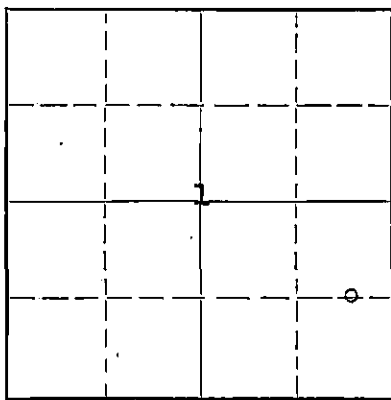

Locate well correctly on above Section Plat

Name of Conservation Agent who supervised plugging of this well M. A. Rives  
Producing formation Viola Depth to top 3737 Bottom 3766 Total Depth of Well 3766 Feet  
Show depth and thickness of all water, oil and gas formations.

OIL, GAS OR WATER RECORDS

CASING RECORD

Formation	Content	From	To	Size	Put In	Pulled Out
Viola	Oil & Water	3762	3766	8 5/8" 4 1/2"	254' 3742'	None 1519'

Describe in detail the manner in which the well was plugged, indicating where the mud fluid was placed and the method or methods used in introducing it into the hole. If cement or other plugs were used, state the character of same and depth placed, from \_\_\_\_\_ feet to \_\_\_\_\_ feet for each plug set.

Filled back with sand to 3735'. Dumped 5 sacks of cement at 3735'. Shot pipe off at 1519'. Pulled pipe and mudded hole to 250'. Set rock bridge at 250' and dumped 20 sacks of cement. Mudded hole to 35' and set rock bridge. Finished mudding hole & put 10 sacks of cement at top of surface.

RECORDED  
STATE CORPORATION COMMISSION  
7-22-52

Name of Plugging Contractor Bert Self  
Address 419 E. 6th, Hutchinson, Kansas


STATE OF KANSAS, COUNTY OF SEDGWICK, ss.  
F. W. Heiser (employee of owner) or (owner/operator) of the above-described well, being first duly sworn on oath, says: That I have knowledge of the facts, statements, and matters herein contained and the log of the above-described well as filed and that the same are true and correct. So help me God

(Signature) *F. W. Heiser*  
Assistant-to-the-President  
422 W. Douglas, Wichita, Kansas, Box 1030  
(Address)

SUBSCRIBED AND SWORN to before me this 21st day of July, 19 52

My commission expires August 24, 1953

*H. A. Wilson*  
Notary Public.

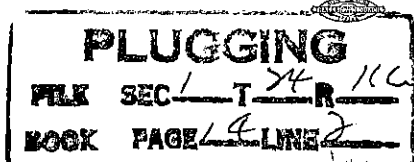

THE DERBY OIL COMPANY

Record of Well #1  
 Location: App. CEL SE/4 (1320'  
 S. Line, 495' E. Line)  
 Contractor: E. K. Carey  
 Drilling Commenced: 6-23-42  
 Elevation: 1803'

Mc Nickle Farm  
 Sec. 1 Twp. 24 Rge. 11W  
 County: Stafford  
 Drilling Completed: 7-25-42  
 State of Kansas

CASING RECORD

Size	Feet	Kind	
8-5/8" O.D.	254	Sur. Casing	Cemented with 75 sacks Atlas Regular and 65 sacks Atlas High Early Strength Cement.
4-1/2" O.D.	3742	Republic-9 1/2" Electric Weld	Cemented with 117 sacks regular Lehigh Cement

Formation	Bottom	Formation	Bottom
-----------	--------	-----------	--------

Sand	159
Red Rock	255
Shale & shells	990
Shale	1180
Salt	1340
Lime	1385
Poros Lime	1472
Lime	1920
Shale & Lime	2280
Shale	2445
Shale & Lime	2640
Lime	3202
Broken Lime	3228
Gray Lime	3251
Shale & Lime	3322
Lime	3363
Poros Lime	3371
Lime	3407
Poros Lime	3431
Lime	3648
Lime & Shale	3688
Shale	3711
Sand	3721
Sandy Lime	3724
White Chert	3727
Chert, Lime & Traces Green Shale	3743

CABLE TOOLS

Viola	3766
Pay	3762-66
Filled up 1500' oil/16 hrs. Gave 500 acid, flowed 85 bbls. oil/2 hrs.	
Bomb Pot. 989 oil and 52 water	

GEOLOGICAL DATA

Lansing	3329
Misener	3713
Viola	3737

(SIM 3742 - 46)

**PLUGGING**  
 PLS SEC - LT. 24 R. 11W  
 BOOK PAGE 14 LINE 2

RECEIVED  
 STATE GEOLOGICAL COMMISSION  
 CONSERVATION DIVISION  
 Wichita, Kansas