


STATE OF KANSAS
STATE CORPORATION COMMISSION

WELL PLUGGING RECORD

Give All Information Completely
Make Required Affidavit
Call or Deliver Report to:
Conservation Division
State Corporation Commission
800 Biting Building
Wichita, Kan.

OR
FORMATION PLUGGING RECORD

Strike out upper line
when reporting plugging
off formations.

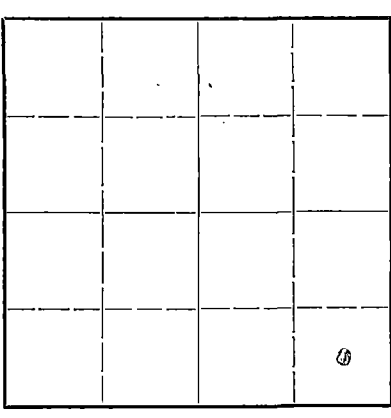

Locate well correctly on above
Section Plat

Stafford County. Sec. 2 Twp. 24 Rge. (E) 11 (W)
Location as "NE 1/4 NW 1/4 SW 1/4" or footage from lines 585' fr EL 330' fr SL SE/4
Lease Owner Bay Petroleum Corporation,
Lease Name McNickle Well No. 1
Office Address Box 957, Denver, Colorado
Character of Well (completed as Oil, Gas or Dry Hole) Oil well
Date well completed 12-7-46 1940
Application for plugging filed 2-11 1947
Application for plugging approved 2-13 1947
Plugging commenced 2-13- 1947
Plugging completed 2-21-47 1947
Reason for abandonment of well or producing formation Stopped producing
enough to warrant continued operation.
If a producing well is abandoned, date of last production 3-23 1946
Was permission obtained from the Conservation Division or its agents before plugging was
commenced? Yes

Name of Conservation Agent who supervised plugging of this well H.W. Kerr
Producing formation Viola Depth to top 3698' Bottom 3760' Total Depth of Well 3760' Feet
Show depth and thickness of all water, oil and gas formations.


OIL, GAS OR WATER RECORDS

CASING RECORD

Formation	Content	From	To	Size	Put In	Pulled Out
				13"	184'	None
				8"	287'	None
				5 1/2"	3715'	1434' 6"

Describe in detail the manner in which the well was plugged, indicating where the mud fluid was placed and the method or methods used in
introducing it into the hole. If cement or other plugs were used, state the character of same and depth placed, from.....feet to
.....feet for each plug set.

Mudded Hole
Set bridge at 215'
Ran 15 sax cement
Mudded hole and ran 10 sacks cement to base of cellar

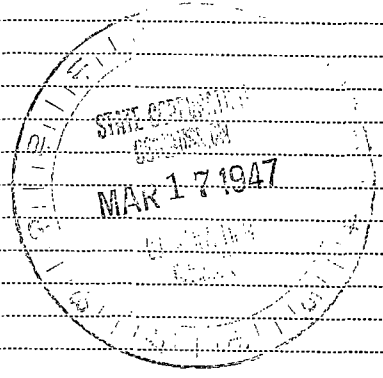

(If additional description is necessary, use BACK of this sheet)

Correspondence regarding this well should be addressed to THE BAY PETROLEUM CORPORATION,
Address BOX 513, CHASE, KANSAS.

STATE OF KANSAS, COUNTY OF RICE, ss.
Forrest Crawford (employee of owner) or (owner or operator) of the above-described well,

being first duly sworn on oath, says: That I have knowledge of the facts, statements, and matters herein contained and the log of the above-
described well as filed and that the same are true and correct. So help me God.

(Signature) Forrest Crawford
(Address)

SUBSCRIBED AND SWORN to before me this 14 day of March, 1947

My commission expires May 20 1950
Notary Public.

WELL LOG BUREAU* KANSAS GEOLOGICAL SOCIETY
412 Union National Bk. Bldg., Wichita, Kansas.

McNickle No. 1
PETRO. CORP.

Sec. 2 T. 24 R. 11W
SW SE SE SE
585' fr EL 330 fr SL SE/4

Total Depth. 3760'
Comm. 11-15-40 Comp. 12-7-40
Shot or Treated.
Contractor.
Issued. 1-25-41

County. STAFFORD

Casing;
13" 184'
8" 287'
5 1/2" 3715'

Elevation. 1802

Production. Pot. 8038B

Figures indicate bottom of formations.

soiland clay	35	Shale and lime	2656
sand	153	shale	2740
shale	190	shale & lime	2830
sand and shale	240	lime	2837
shale	385	shale	2850
shale red	502	lime	3157
anhydrite	525	shale & lime	3197
shale & shells	948	shale	3224
shale	1040	lime	3264
shale and salt	1345	shale & lime	3288
shale and anhydrite	1554	shale & lime	3338
shale	1610	lime	3411
lime	1645	lime cherty	3420
chert lime	1660	lime & chert strk	3458
shale and lime	1693	lime	3499
shale and lime strks	1855	lime chert	3525
shale and lime	1932	lime	3623
shale	1950	shale	3625
lime	1987	shale and lime	3664
lime brown & shale	2000	shale	3681
lime	2068	lime	3692
shale and lime	2117	shale	3697
shale & lime strks	2202	lime	3713
		chert	3760
		Total Depth.	

