

STATE OF KANSAS  
STATE CORPORATION COMMISSION


WELL PLUGGING RECORD

Give All Information Completely  
Make Required Affidavit  
Mail or Report to:  
Conservation Division  
State Corporation Commission  
800 B'ing Building  
Wichita, Kansas

OR  
FORMATION PLUGGING RECORD

Strike out upper line  
when reporting plugging  
off formations.

Stafford County. Sec. 2 Twp 24S Rge 11 (E) W (W)  
Location as "NE 1/4 NW 1/4 SW 1/4" or footage from lines. 330' South Line, 660' West Line  
Lease Owner Deep Rock Oil Corporation  
Lease Name Anna Turner Well No. 1  
Office Address Box 1051, Tulsa, Oklahoma  
Character of Well (completed as Oil, Gas or Dry Hole) Oil  
Date well completed January 12 19 40  
Application for plugging filed April 20 19 49  
Application for plugging approved April 22 19 49  
Plugging commenced May 2 19 49  
Plugging completed May 6 19 49  
Reason for abandonment of well or producing formation Well went dry

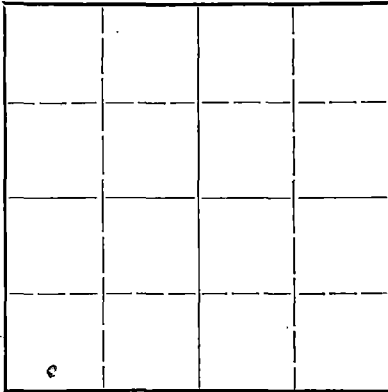

Locate well correctly on above  
Section Plat

If a producing well is abandoned, date of last production July 1 19 48  
Was permission obtained from the Conservation Division or its agents before plugging was commenced? Yes

Name of Conservation Agent who supervised plugging of this well Mr. C.D. Stough  
Producing formation Lime Depth to top 3704 Bottom 3748 Total Depth of Well 3748 Feet  
Show depth and thickness of all water, oil and gas formations.

OIL, GAS OR WATER RECORDS

CASING RECORD

Formation	Content	From	To	Size	Put In	Pulled Out
	Cemented from	top to	bottom.	10 1/2"	211	None
				7" 24#	5687'	2698'

Describe in detail the manner in which the well was plugged, indicating where the mud fluid was placed and the method or methods used in introducing it into the hold. If cement or other plugs were used, state the character of same and depth placed, from \_\_\_\_\_ feet to \_\_\_\_\_ feet for each plug set.

Filled with crushed rock from 3748' to 3680'. Put in 6 sacks cement from 3680' to 3650'. Fill hole with heavy mud to 200' of top. Put 20 sacks cement, filled up from 200' to 175'. Fill hole with mud from 175' to 12' of top. Put in 10 sacks cement to top of hole and in cellar.

RECEIVED  
MAY 23 1949  
ST. CORPORATION  
COMMISSION  
KANSAS  
5-23-49

(If additional description is necessary, use BACK of this sheet)

Correspondence regarding this well should be addressed to Deep Rock Oil Corporation  
Address Box 429, Hutchinson, Kansas

STATE OF \_\_\_\_\_, COUNTY OF \_\_\_\_\_, ss.  
\_\_\_\_\_, (employee of owner) or (owner or operator) of the above-described well,  
being first duly sworn on oath, says: That I have knowledge of the facts, statements, and matters herein contained and the log of the above-described well as filed and that the same are true and correct. So help me God.

(Signature) Jack Smith  
Box 429 - Hutchinson Kansas  
(Address)

SUBSCRIBED AND SWORN to before me this 21st day of May 19 49  
Notary Public.

My commission expires 10/17/51

22-237 7-47-10M  
PLUGGING  
FILE SEC 2 T 24 R 11W  
BOOK PAGE 97 LINE 37

15-185-10135-0000

Anna Turner #1

Sec. 2 Twp. 24S Range 11W  
Stafford County Kansas

Put in 211' of 10 3/4", cemented  
with 250 sacks.

Put in 3687' of 7", cemented with  
225 sacks.

0	80	Surface
80	175	Sand
175	225	Shale and Red Bed
225	250	Shale
250	264	Red Bed
264	502	Red Bed and Shells
502	788	Shale and shells
788	888	Lime and shale
888	1090	Shale and shells
1090	1220	Shale and Salt
1220	1452	Shale and Shells
1452	1756	Shale and Lime
1756	1795	Lime - hard
1795	1804	Shale
1804	2252	Shale and Lime
2252	2280	Lime
2280	2292	Lime and shale
2292	2325	Lime
2325	2470	Shale and Lime
2470	2520	Shale
2520	2560	Lime
2560	2630	Shale
2630	2818	Lime and SShale
2818	3018	Lime
3018	3084	Lime and Shale
3084	3225	Lime
3225	3347	Shale
3347	3465	Lime
3465	3480	Shale
3480	3485	Lime
3485	3490	Shale
3490	3555	Lime
3555	3571	Lime and Shale
3571	3608	Cherty Lime and Shale
3608	3660	Shale and Lime
3660	3684	Shale
3684	3698 $\frac{1}{2}$	Sand
3698 $\frac{1}{2}$	3704	Green Shale
3704	3730	Sand
3730	3748	Lime - Cherty-Hard-Rough
3748		Total Depth

RECEIVED

Com. ...

APR 22 1949

STATE OCCUPATION  
COMMISSION  
KANSAS

**PLUGGING**  
FILE SEC 2 T 24 R 11W  
BOOK PAGE 97 LINE 37