

state

15-185-10132-0000

STATE OF KANSAS  
STATE CORPORATION COMMISSION


WELL PLUGGING RECORD

Give All Information Completely  
Make Required Affidavit  
Mail or Deliver Report to:  
Conservation Division  
State Corporation Commission  
800 Bittling Building  
Wichita, Kansas

OR  
FORMATION PLUGGING RECORD

Strike out upper line  
when reporting plugging  
off formations.

Location as "NE $\frac{1}{4}$ NW $\frac{1}{4}$ SW $\frac{1}{4}$ " or footage from lines SW NW SW $\frac{1}{4}$   
Lease Owner Shell Oil Co., Inc.  
Lease Name A. C. Brown Well No. 1  
Office Address Box 744, Great Bend, Kansas  
Character of Well (completed as Oil, Gas or Dry Hole) Oil  
Date well completed July 10 19 40  
Application for plugging filed September 8 19 47  
Application for plugging approved September 10 19 47  
Plugging commenced September 15 19 47  
Plugging completed September 20 19 47  
Reason for abandonment of well or producing formation Oil Depleted

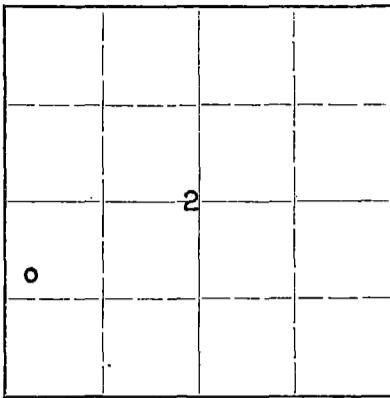

Locate well correctly on above  
Section Plat

If a producing well is abandoned, date of last production February 4 19 47  
Was permission obtained from the Conservation Division or its agents before plugging was commenced? Yes

Name of Conservation Agent who supervised plugging of this well H. W. Kerr  
Producing formation Viola Depth to top 3698 Bottom Total Depth of Well 3763 Feet  
Show depth and thickness of all water, oil and gas formations.


OIL, GAS OR WATER RECORDS

CASING RECORD

Formation	Content	From	To	Size	Put In	Pulled Out
Viola	Ind. Cap. 3450 oil & 0 water per 24 hours; 1,097,000 cu. ft. gas/day.	3701	3763	8 5/8" 4 1/2"	255 3701	None 1788'

Describe in detail the manner in which the well was plugged, indicating where the mud fluid was placed and the method or methods used in introducing it into the hold. If cement or other plugs were used, state the character of same and depth placed, from...feet to...feet for each plug set.

Ran 5 sax cement on bottom. Filled hole with heavy mud to 260'. Dumped 10' of crushed rock. Dumped 15 sacks of cement to 250'. Mudded hole to 28'. Dumped 10 sacks cement; filled to base of cellar.

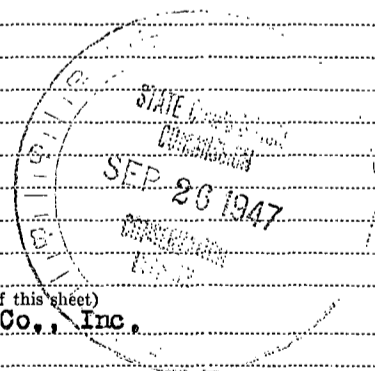

(If additional description is necessary, use BACK of this sheet)  
Correspondence regarding this well should be addressed to Shell Oil Co., Inc.  
Address c/o W. M. Gholson, Box 744, Great Bend, Kansas


STATE OF KANSAS COUNTY OF BARTON, ss.  
W. M. Gholson (employee of owner) of the above-described well,  
being first duly sworn on oath, says: That I have knowledge of the facts, statements, and matters herein contained and the log of the above-described well as filed and that the same are true and correct. So help me God.

(Signature) *W. M. Gholson*  
Box 744, Great Bend, Kansas  
(Address)

SUBSCRIBED AND SWORN to before me this 25th day of September, 19 47

My commission expires January 24, 1949


*Betty Postlethwaite*  
Notary Public.

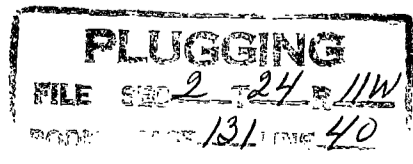

SHELL, A. C. BROWN #1  
 SW NW SW 2-24S-11W  
 Zenith District  
 Stafford County, Kansas

CASING RECORD

0 - 155 surface soil & sand	3511 lime & small amount chert
255 red rock	3606 lime
350 red bed & sand	3630 lime & chert
510 red bed	3659 lime & some chert
555 red bed & sand	3662 lime & shale
580 anhydrite	3674 shale, v.c. chert
690 shale	Top Sooy Conglomerate 3664.
825 shale & shells	3680 sand
1075 red rock, shale & shells	Top Kinderhook 3680
1143 salt, shale & shells	3693 shale
1380 salt, sandy shale & shells	3695 chert
1390 lime	Top Misener Zone 3693
1428 shale & lime	3698 shale, some chert & streaks sand
1492 anhydrite & shale	Top Viola 3698
1584 anhydrite	3704 dolomite, gillsonitic & argillaceous
1650 shale & shells	3711 lime, dolomitic
1662 shale & lime	3719 lime
1670 chert & shale	3762 chert, lime & dolomite
1702 lime & shale	3763 chert, some lime & dolomite streaks, T.D.
1864 shale, lime & chert	
1872 lime & chert	
1936 shale, lime & streaks chert	
2021 lime & shale	
2310 lime & shale	
2393 shale & lime shells	
2416 shale & lime streaks	
2825 lime & shale	
2838 lime & shale streaks	
2860 shale & lime	
Top Topeka 2857	
2899 lime	
2949 lime & shale	
3137 lime	
3360 lime & shale	
3428 lime Top Lansing-Kansas City 3344	
3434 lime & chert	
3465 lime & chert streaks	
3471 lime & chert	

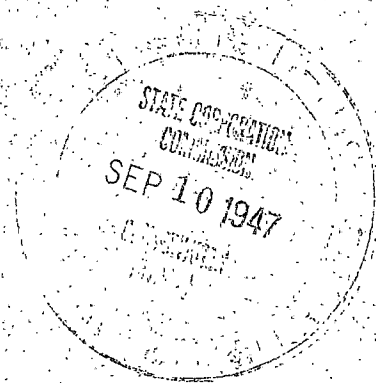

PLUGGING  
 FILE SEC 2 T 24 R 11W  
 BOOK PAGE 131 LINE 40