


15-095-00246-0000

WELL PLUGGING RECORD

Give All Information Completely
Make Required Affidavit
Mail or Deliver Report to:
Conservation Division
State Corporation Commission
212 North Market, Insurance Bldg.
Wichita, Kansas

Kingman County, Sec. 33 Twp. 27 Rge. 5W (E) (W)

Location as "NE/CNW/SW" or footage from lines NE NE SE
Lease Owner Shawver Armour
Lease Name Johnson # 1 Well No. 21
Office Address 817 Central Bldg. Wichita, Kansas
Character of Well (completed as Oil, Gas or Dry Hole) oil
Date well completed September 22, 19 59
Application for plugging filed October 19 19 59
Application for plugging approved October 21 19 59
Plugging commenced October 20 19 59
Plugging completed October 23 19 59
Reason for abandonment of well or producing formation dry

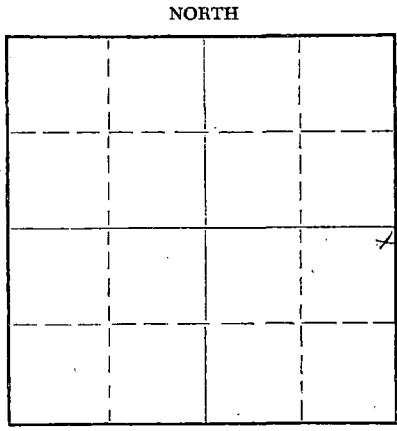

Locate well correctly on above Section Plat

If a producing well is abandoned, date of last production _____ 19 _____
Was permission obtained from the Conservation Division or its agents before plugging was commenced? yes

Name of Conservation Agent who supervised plugging of this well Fred Hampell
Producing formation _____ Depth to top _____ Bottom _____ Total Depth of Well 3798 Feet
Show depth and thickness of all water, oil and gas formations.

OIL, GAS OR WATER RECORDS

CASING RECORD

FORMATION	CONTENT	FROM	TO	SIZE	PUT IN	PULLED OUT

Describe in detail the manner in which the well was plugged, indicating where the mud fluid was placed and the method or methods used in introducing it into the hole. If cement or other plugs were used, state the character of same and depth placed, from _____ feet to _____ feet for each plug set.

Sand to 3750, dumped 5 sacks cement mud to 170' set 10' rock bridge with 20 sacks cement mud to 35' set 10' rock with 10 sacks cement.

RECEIVED
STATE CORPORATION COMMISSION
OCT 28 1959
CONSERVATION DIVISION
Wichita, Kansas

(If additional description is necessary, use BACK of this sheet)
Name of Plugging Contractor Southwest Casing Pulling Co., Inc.
Address Box 364, Great Bend, Kansas

STATE OF Kansas, COUNTY OF Barton, ss.
Southwest Casing Pulling Co., Inc. (employee of owner) or (owner or operator) of the above-described well, being first duly sworn on oath, says: That I have knowledge of the facts, statements, and matters herein contained and the log of the above-described well as filed and that the same are true and correct. So help me God.
(Signature) Roy L. Myers Roy L. Myers
Sec. Treas.
Box 364, Great Bend, Kansas (Address)

SUBSCRIBED AND SWORN TO before me this 27 day of October, 19 59
Juanita R. Myers Notary Public.
My commission expires December 18, 1962



15-095-00246-00-00

DRILLER'S LOG

FARM NAME: JOHNSON # 1 LOCATION: NE NE SE SEC. 33-27-5W
 Kingman County, Kansas
CONTRACTOR: SHAWVER-ARMOUR, INC. ELEVATION: 1453 K. B.
OWNER: SHAWVER-ARMOUR, INC.
COMMENCE: SEPTEMBER 12, 1959 COMPLETED: SEPTEMBER 22, 1959
CASING RECORD: 175' 8-5/8" W/160 Sx. Cement - 2% C.C.
 3770' 5-1/2" W/150 Sx. Cement

<u>FORMATION:</u>		<u>TOPS:</u>	
Sand & Gravel	50	Stalnaker	1950
Red Bed & Blue Shale	230	Kansas City	2983
Gray Shale	770	Mississippian Chert.	3753
Shale	825	Mississippian Dolomite	3782
Anhydrite	970		
Shale & Lime	1230		
Lime & Shale	1615		
Shale - Lime	1950		
Stalnaker Sand	2025		
Lime - Shale	2983		
Kansas City Lime	3126		
Lime - Shale	3178		
Kansas City Lime	3294		
Chert. & Lime	3340		
Lime	3485		
Lime & Shale	3753		
Mississippian chert. & lime	3773		
Mississippian chert & dolomite	3788 T.D.		

RECEIVED
 STATE CORPORATION COMMISSION
 OCT 28 1959
 CONSERVATION DIVISION
 Wichita, Kansas

STATE OF KANSAS)
) SS
 SEDGWICK COUNTY)

I, James M. Armour, do hereby certify that the above log is a true and correct copy of the above captioned well as shown on the daily drilling reports.

SHAWVER-ARMOUR, INC.

BY James M. Armour
 JAMES M. ARMOUR

Subscribed and sworn to before me this 23rd day of September, 1959.

My commission expires December 29th, 1959

Marjorie Hall
 MARJORIE HALL-NOTARY PUBLIC