


15-095-20176-0000

STATE OF KANSAS
STATE CORPORATION COMMISSION

Give All Information Completely
Make Required Affidavit
Mail or Deliver Report to
Conservation Division
State Corporation Commission
245 North Water
Wichita, KS 67202

FORM CP-4

WELL PLUGGING RECORD

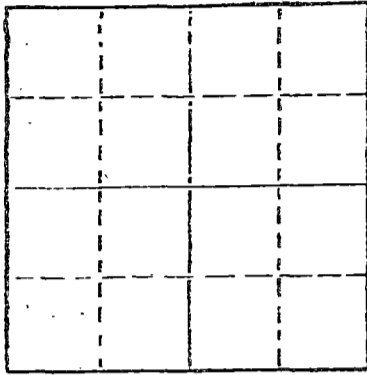

Locate well correctly on above
Section Plat

Kingman County. Sec. 35 Twp. 27 Rge. 5 (E) X (W)
Location as "NE/CNW/SWK" or footage from line NE NE
Lease Owner Triple D Drilling Company, Inc.
Lease Name Grace Well No. 1
Office Address 217 East First, Hutchinson, KS 67501
Character of Well (completed as Oil, Gas or Dry Hole) D&A
Date well completed _____ 19____
Application for plugging filed _____ 19____
Application for plugging approved _____ 10-9 19 69
Plugging commenced _____ 19____
Plugging completed _____ 10-7 19 69
Reason for abandonment of well or producing formation _____

If a producing well is abandoned, date of last production _____ 19____
Was permission obtained from the Conservation Division or its agents before plugging was commenced? Yes

Name of Conservation Agent who supervised plugging of this well R. J. Warren
Producing formation _____ Depth to top _____ Bottom _____ Total Depth of Well 3840 Feet
Show depth and thickness of all water, oil and gas formations.

OIL, GAS OR WATER RECORDS

CASING RECORD

FORMATION	CONTENT	FROM	TO	SIZE	PUT IN	PULLED OUT

Describe in detail the manner in which the well was plugged, indicating where the mud fluid was placed and the method or methods used in introducing it into the hole. If cement or other plugs were used, state the character of same and depth placed, from _____ feet to _____ feet for each plug set.

230' 8 5/8" surface pipe circulated with cement, mud to 230'. 1/2 sack hulls a plug 25 sacks cement, mud to 40' 1/2 sack hulls a plug, 10 sacks cement to surface. Bridge rat hole 2 sacks cement.

Name of Plugging Contractor Co. Tools (If additional description is necessary, use BACK of this sheet)
Address _____

STATE OF _____ COUNTY OF _____, ST.

_____, (employee of owner) or (owner or operator) of the above-described well, being first duly sworn on oath, says: That I have knowledge of the facts, statements, and matters herein contained and the log of the above-described well as filed and that the same are true and correct. So help me God.

(Signature) _____
(Address) _____

SUBSCRIBED AND SWORN TO before me this _____ day of _____, 19____

My commission expires _____ Notary Public.

RCW
10-09-69