


STATE OF KANSAS  
STATE CORPORATION COMMISSION

WELL PLUGGING RECORD

Give All Information Completely  
Make Required Affidavit  
Mail or Deliver Report to  
Conservation Division  
State Corporation Comm.  
245 North Water  
Wichita, KS 67202

Kingman County. Sec. 36 Twp. 27S Rge. 5 E/W  
Location as "NE/CNW $\frac{1}{4}$ SW $\frac{1}{4}$ " or footage from lines  
SW SE SW  
Lease Owner Vincent Oil Corporation  
Lease Name Dieffenbacher Well No. One  
Office Address 901 Union Center Building Wichita, Kansas  
Character of Well (Completed as Oil, Gas or Dry Hole)  
Dry Hole

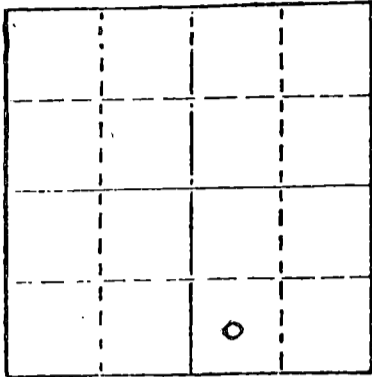

Locate well correctly on above  
Section Plat

Date Well completed 7-5-77 19  
Application for plugging filed 7-5-77 19  
Application for plugging approved 7-5-77 19  
Plugging commenced 7-5-77 19  
Plugging completed 7-5-77 19  
Reason for abandonment of well or producing formation  
Dry Hole

If a producing well is abandoned, date of last production 19

Was permission obtained from the Conservation Division or its agents before plugging was commenced? Yes

Name of Conservation Agent who supervised plugging of this well J. H. Mets  
Producing formation None Depth to top Bottom Total Depth of Well 3,837  
Show depth and thickness of all water, oil and gas formations.

OIL, GAS OR WATER RECORDS

CASING RECORD

FORMATION	CONTENT	FROM	TO	SIZE	PUT IN	PULLED OUT
				8 5/8"	225	None

Describe in detail the manner in which the well was plugged, indicating where the mud fluid was placed and the method or methods used in introducing it into the hold. If cement or other plugs were used, state the character of same and depth placed, from feet to feet for each plug set.

Plug @ 40' W/10sks Cement

Plug @ 240' W 40 sks Cement

Mud 240' to 3837

s sks rat hole

RECEIVED  
STATE CORPORATION COMMISSION  
JUL 12 1977  
CONSERVATION DIVISION  
Wichita, Kansas

(If additional description is necessary, use BACK of this sheet)

Name of Plugging Contractor Big Springs Drilling, Inc.

STATE OF Kansas COUNTY OF Sedgwick, ss.  
Paul A. Seymour, Jr. (employee of owner) or (owner or operator)  
of the above-described well, being first duly sworn on oath, says: That I have knowledge of the facts, statements, and matters herein contained and the log of the above-described well as filed and that the same are true and correct. So help me God.

(Signature) Paul A. Seymour, Jr.  
P. O. Box 8287, Munger Station  
(Address) Wichita, Kansas

SUBSCRIBED AND SWORN TO before me this 11th day of July, 1977

My commission expires May 30, 1979

Ruth M. Bassett  
Ruth M. Bassett Notary Public.

15-095-20598-0000

# BIG SPRINGS DRILLING, INC.

P.O. BOX 8287  
MUNGER STATION  
WICHITA, KANSAS 67208

SUITE 29 • 400 NORTH WOODLAWN • (316) 681-1732

July 11, 1977

## DRILLERS LOG

#1 Dieffenbacher  
SW SE SW  
36 27S 5W  
Kingman County, Kansas

OPERATOR : Vincent Oil Corporation  
CONTRACTOR: Big Springs Drilling, Inc.  
COMMENCED: 6-25-77  
COMPLETED: 7-5-77

Surface Pipe 8 5/8" @ 225' W/200 Sk

0	225	Surface Clay	
225	825	Shale & Red Beds	
825	3281	Lime & Shale	
3281	3423	Lime	
3423	3608	Lime & Shale	
3608	3704	Lime, Shale & Chert	
3704	3785	Lime, Shale & Mississippi	
3785	3837	Mississippi	
3837		RTD	D & A


RECEIVED  
STATE CORPORATION COMMISSION  
JUL 12 1977  
CONSERVATION DIVISION  
Wichita, Kansas

We certify that the above and foregoing is a true and correct copy of the log on the #1 Dieffenbacher located in Kingman County, Kansas.

BIG SPRINGS DRILLING, INC.

  
Paul A. Seymour, Jr.

Subscribed and sworn to before me this 11 th day of July, 1977.

  
Ruth M. Bassett Notary Public