


Give All Information Completely
Make Required Affidavit
Mail or Deliver Report to:
Conservation Division
State Corporation Commission
211 No. Broadway
Wichita, Kansas

R

WELL PLUGGING RECORD

15-095-00176-0001

NORTH

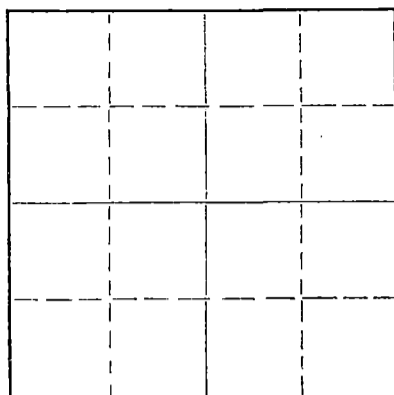

Locate well correctly on above
Section Plat

Kingman County. Sec. 13 Twp. 27 Rge. 10 (E) W (W)
Location as "NE/CNW/SW" or footage from lines SW C NW
Lease Owner ~~XXXXXXXXXXXXXXXXXXXX~~ Morgenstern & Spector
Lease Name McMichaels "A" #1 Well No.
Office Address Russell, Kansas
Character of Well (completed as Oil, Gas or Dry Hole) oil
Date well completed 10-5-45 19
Application for plugging filed 11-14-59 19
Application for plugging approved 11-15-59 19
Plugging commenced 11-16-59 19
Plugging completed 11-19-59 19
Reason for abandonment of well or producing formation failure to produce
profitably
If a producing well is abandoned, date of last production 19
Was permission obtained from the Conservation Division or its agents before plugging was commenced? yes

Name of Conservation Agent who supervised plugging of this well Fred Hampel
Producing formation Viola Depth to top 4284 Bottom 4291 Total Depth of Well 4500 Feet
Show depth and thickness of all water, oil and gas formations.

OIL, GAS OR WATER RECORDS

CASING RECORD

FORMATION	CONTENT	FROM	TO	SIZE	PUT IN	PULLED OUT
				9-5/8"	315'	none
				5-1/2"	4350'	3213'

Describe in detail the manner in which the well was plugged, indicating where the mud fluid was placed and the method or methods used in introducing it into the hole. If cement or other plugs were used, state the character of same and depth placed, from _____ feet to _____ feet for each plug set.

Checked the hole to 4300' and found it open.
Ran 40 sand to 4265' and dumped 5 sacks of cement with bailer. Pulled 5 1/2" casing.
Cleared hole and checked fluid to 60', bailed hole to 300' and mudded from 360' to 300', set rock bridge to 290' and dumped 20 sacks of cement. Mudded the hole to 35', set rock bridge to 30' and ran 10 sacks of cement to base of cellar.

RECEIVED
STATE CORPORATION COMMISSION

PLUGGING COMPLETED

JAN 19 1960

(If additional description is necessary, use BACK of this sheet)
Name of Plugging Contractor Knight Casing Pulling Co. CONSERVATION DIVISION
Address Chase, Kansas Wichita, Kansas

STATE OF KANSAS COUNTY OF RICE, ss.
I, Noel J. Knight (employee of owner) or (owner/operator) of the above-described well, being first duly sworn on oath, says: That I have knowledge of the facts, statements, and matters herein contained and the log of the above-described well as filed and that the same are true and correct. So help me God.

(Signature) Noel Knight
Chase, Ks. (Address)

SUBSCRIBED AND SWORN TO before me this 23rd day of November, 1959

Thomas V. Duggs
Notary Public.

My commission expires 9-27-62



WELL LOG BUREAU KANSAS GEOLOGICAL SOCIETY
412 Union National Bk. Bldg., Wichita, Kansas


15-095-00176-0001

Company - LIÓN OIL CO.
Farm - McMichael No. 1.

SEC. 13 T. 27 R. 10 W
SWc NW

Total Depth. 4500
Comm. 9-9-45 Comp. 10-5-45
Shot or Treated.
Contractor. R.W. Rine Drlg. Co.
Issued. 12-15-45

County. Kingman
KANSAS

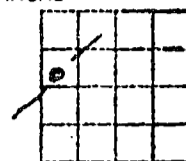

CASING:

9" 315' Cem.
5 1/2" 4350 - 200 ft

Elevation. _____

Production. Dry 328 BOPD
DWWO

Figures Indicate Bottom of Formations.

sand & gravel	0-170
red bed	281
shale & shells	315
red bed & shale	505
shale & shells	1234
shale & lime	1440
anhydrite	1615
shale	1680
shale & salt	1825
lime	1935
lime & shale	2060
shale & shells	2195
lime & shale	2350
shale & shells	2480
lime & shale	3045
lime	3356
sand	3390
lime	3400
sand	3416
lime & shale	3506
lime	4040
lime & chert	4087
shale	4273
lime & shale	4292
lime	4323
lime & sand	4363
shale & sand	4385
sand	4425
shale	4460
lime	4500
Total Depth	

*Washed this hole down
& produced it.*

RECEIVED
STATE CORPORATION COMMISSION

NOV 25 1959

CONSERVATION DIVISION
Wichita, Kansas

Tops:

Lansing	3506
Miss.	4018
Kinderhook	4067
Viola	4284
Simpson	4367
Arbuckle	4467

CCG